


Woodson

Form 51-5M-2-29-34703

Map No. KANSAS Sec. 29 Twp. 23 R. 14

Well No. 6-Headley Farm
Travelers Oil Company

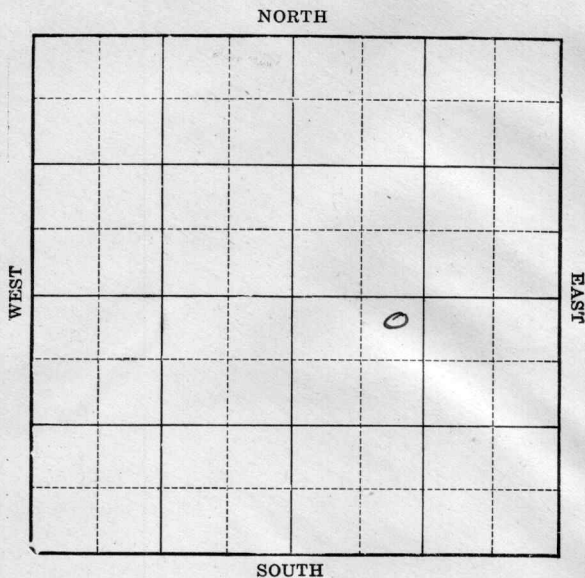

Location _____
Drilling Remarks _____

Rig Up _____
Drilling Remarks _____

RECORD

Cased _____ in. _____ ft.
Sand _____
Gas _____
Oil _____
Total Depth _____

PRODUCTION

1st 24 hrs. Nat. _____
1st 24 hrs. after shot _____
Gas _____ cu. ft.
Dry Hole _____
Abandoned _____

Woodson

Map No. _____ Sec. 29 Twp. 23 R. 14Well No. 6 Headley
Travelers Oil Co Company

Contractor

FIRST REPORTS
COMPLETED

SECTION PLAT

		o	

_____ Ft. from N. Line

_____ Ft. from S. Line

_____ Ft. from E. Line

_____ Ft. from W. Line

Location _____

Rig up _____

Drilling and Remarks:

Prod Well.

No Record.

RECORD

Cased _____ in., _____ ft.

Sand _____

Gas _____

Oil _____

Total Depth _____

PRODUCTION

1st 24 hrs. Nat. _____

1st 24 hrs. after shot _____

Gas _____ Cu. Ft.

Dry Hole _____

Abandoned _____

Date

2/22/22 192

Sherwood

Scout