

Woodson

KANSAS

Section 29 Township 23 Range 14 - EWell No. 8 Headley "C"Company Sinclair Prairie

NORTH

WEST							EAST
0							

SOUTH

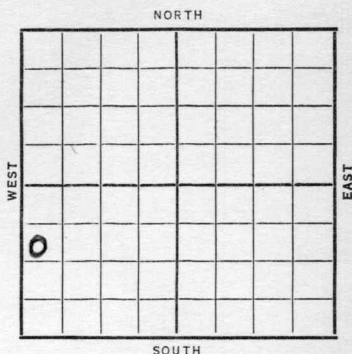
KANSAS

Woodson

Sec. 29 Twp. 23 R. 14-EWell No. #8 Headley "C" FarmSinclair-Prairie Company1050 Ft. from N. Line

Ft. from S. Line

Ft. from E. Line

220 Ft. from W. Line

Date

REPORT

1938

7/27

RUM

8/5

Drlg. 600'.

8/12

10" - 908'. Dlg. 1035'.

8/19

8" - 1208'. Miss. 1659'.

6" - 1661'. WOC.

8/24

6" at 1661'.

Miss. 1659'.

T. D. 1707'.

2000 acid.

8 bbls. oil.

COMPLETED

Map No. 17 Sec. 29 Twp. 23 R. 14EWell No. 8 Headley "C"Sinclair Prairie

Company

Contractor

FIRST REPORT

Approx

SW NW SW

1050 Ft. from N. Line

Ft. from S. Line

Ft. from E. Line

220 Ft. from W. Line

SECTION PLAT

0			

Location _____

Rig up _____

Drilling and Remarks:

RUM

RECORD

Cased _____ in., _____ ft.

Sand _____

Gas _____

Oil _____

Total Depth _____

PRODUCTION

1st 24 hrs. Nat. _____

1st 24 hrs. after shot _____

Gas _____ Cu. Ft.

Dry Hole _____

Abandoned _____

Date

JUL 27 1938

19

H. D. Hatfield Scout

Map No. 17 Sec. 29 Twp. 23 R. 14EWell No. 8 Headley "C"Sinclair Prairie

Company

Contractor

COMPLETED

Approx.

SW NW SW

1050 Ft. from N. Line

_____ Ft. from S. Line

_____ Ft. from E. Line

220 Ft. from W. Line

SECTION PLAT

Location _____

Rig up _____

Drilling and Remarks:

*2000 acid**8 bbls oil*

RECORD

Cased 6 in., 1661 ft.Sand MISS 1659

Gas _____

Oil _____

Total Depth 1707

PRODUCTION

1st 24 hrs. Nat. _____

1st 24 hrs. after shot _____

Gas _____ Cu. Ft.

Dry Hole _____

Abandoned _____

Date

AUG 24 1938 19H. D. Hatfield Scout