

KANSAS

Section 29 Township 23 Range 14-EWell No. #18 McClaskeyCompany Sinclair-Prairie
Miscellaneous

NORTH

			Q				

WEST

EAST

SOUTH

KANSAS

Woodson

Sec. 29 Twp. 23 R. 14E

Well No. #18 McClaskey Farm

Sinclair-Prairie Company

Miscellaneous


 Ft. from N. Line

990' Ft. from S. Line

330' Ft. from E. Line

 Ft. from W. Line

NE SE NW

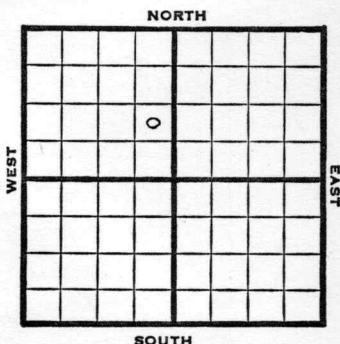

1948

REPORT

6/23 Location
6/29 Drlg 650'
7/8 Drlg 1420'
7/14 8"@ 1260'
Mississippi 1641'
TD 1685
6"@ 1641'
2500 acid
7/21 TD 1685'
Miss 1641'
6"@ 1641'
2000 acid
Pump 27 Oil / 15 W Poy
38° Gr.
Comp.

COMPLETED

Map No. _____ Sec. 29 Twp. 23 R. 14E

Well No. 18 McClaskey

Sinclair-Prairie Company

FIRST REPORT

Contractor

NE SE NW

SECTION PLAT

_____ Ft. from N. Line

990 Ft. from S. Line

330 Ft. from E. Line

_____ Ft. from W. Line

Woodson County

Location X

Rig up _____

Drilling and Remarks:

RECORD

Cased _____ in., _____ ft.

Sand _____

Gas _____

Oil _____

Total Depth _____

PRODUCTION

1st 24 hrs. Nat. _____

1st 24 hrs. after shot _____

Gas _____ Cu. Ft.

Dry Hole _____

Abandoned _____

Date

JUN 23 1948 19 S. J. LEWIS Scout

Map No. 17 Sec. 29 Twp. 23 R. 14E

Well No. 18 McClaskey

Sinclair-Prairie Company

COMPLETE

Contractor

NE SE NW

SECTION PLAT

	o		

 Ft. from N. Line

990 Ft. from S. Line

330 Ft. from E. Line

 Ft. from W. Line

Woodson County

Location

Rig up

Drilling and Remarks:

*Mis 1641
6" @ 1641
2000 rods
Pump 27 oil + 15 W
Bd*

38° S

RECORD

Cased in., ft.

Sand

Gas

Oil ✓

Total Depth 1655

PRODUCTION

1st 24 hrs. Nat.

1st 24 hrs. after shot

Gas Cu. Ft.

Dry Hole

Abandoned

Date

JUL 21 1948

19

S. J. LEWIS

Scout