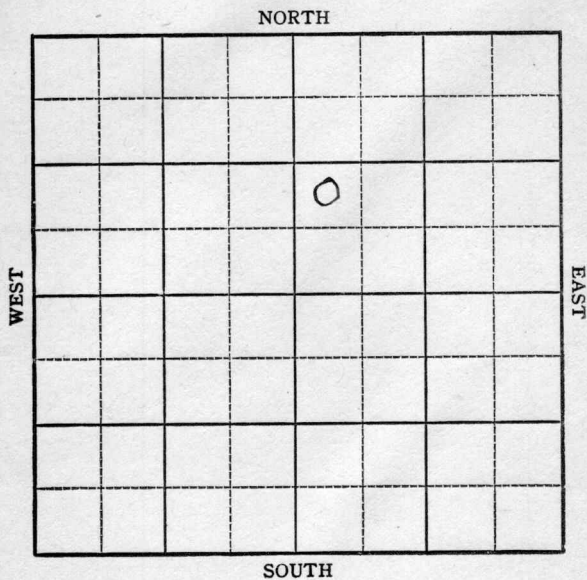


KANSAS Woodson

Section 29 Township 23 Range 14EWell No. 23 McClaskeyCompany Barbara Oil

Sec. 29 Twp. 23 R. 14-E

Well No. #23 McClaskey Farm

Barbara Oil Company

Miscellaneous


 Ft. from N. Line

990 Ft. from S. Line

 Ft. from E. Line

330 Ft. from W. Line

NW SW NE

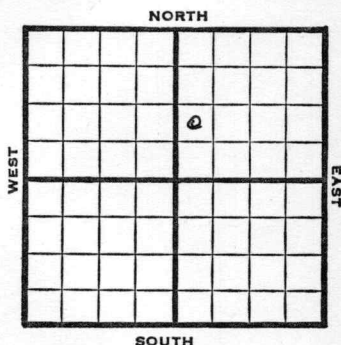

1948	Elev. -	REPORT
8/11		Machine
8/18		Drlg 850'
8/25		10"@ 848'
		8"@ 1260'
		Drlg 1665'
9/1		Mississippi 1676'
		6" @ 1686'
		TD 1700'
9/8		Miss 1676'
		6" @ 1686'
		TD 1700'
		2000 Acid
		Pump 15 oil Pot.
		Gr. 38°
		COMPLETED

Woodson County Kansas State

Map No. _____ Sec. 29 Twp. 23 R. 14E

Well No. 23 McClaskey


Barbara Oil Company

FIRST REPORT

Contractor

NW SW NE

SECTION PLAT

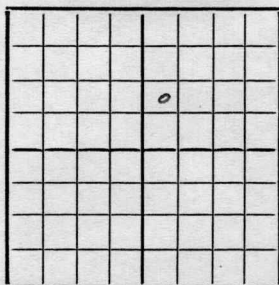

_____ Ft. from N. Line

990 Ft. from S. Line

_____ Ft. from E. Line

330 Ft. from W. Line

Miscellaneous

Remarks:

Machine

Date AUG 11 1948

Scout S. J. LEWIS

Woodson County Kansas State

Map No. 17 Sec. 29 Twp. 23 R. 14E

Well No. 23 McClaskey

Barbara Oil Company

COMPLETE Contractor

NW SW NE

SECTION PLAT

 Ft. from N. Line

990 Ft. from S. Line

 Ft. from E. Line

330 Ft. from W. Line

Miscellaneous

Remarks:

Miss 1676

6" @ 1686

TD 1700

20000 acid

Pump 15 oil Rd

38° 34'

Date
SEP 8 1948

Scout S. J. LEWIS