

Section 30 Township 23 Range 14-E

Well No. #3 Jones


Company Fairway

Miscellaneous

NORTH

WEST

EAST

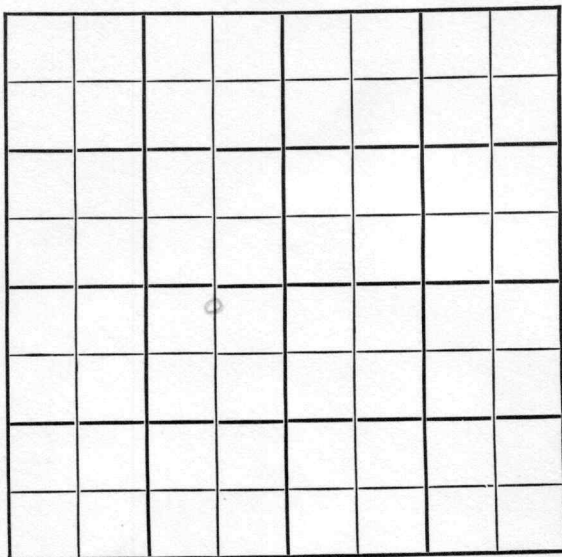

SOUTH

Sec. 30 Twp. 23 R. 14-E

Well No. #3 Jones Farm

Fairway Company

Woodson


330 Ft. from N. Line

 Ft. from S. Line

660 Ft. from E. Line

 Ft. from W. Line

C N L NE SW

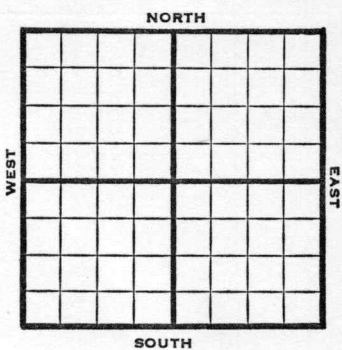

1948

7/8

REPORT

TD 1683'
8"@ 40'
Miss 1668'
7"@ 1668'
2000 acid
30 Pot.
First Report & Comp.
FIRST REPORT
COMPLETED

KANSAS

Woodson



Sec. 30 Twp. 23 R. 14E

Well No. #3 Jones Farm

Fairway Company

Miscellaneous


330' Ft. from N. Line

Ft. from S. Line

660' Ft. from E. Line

Ft. from W. Line

C N L NE SW

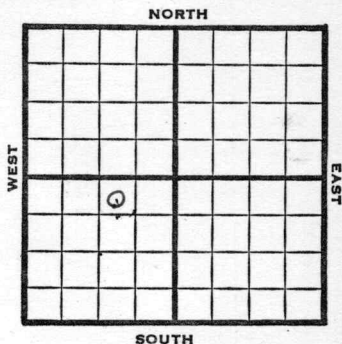

1948

REPORT

7/8

8" @ 40'
Miss. 1668'
7" @ 1668'
2000 acid
30 Pot.

8/11

" ?

9/15

Letter sent to Lewis - reg. Comp
+ kkt. on 9-15-48
Miss 1668'
7" @ 1668'
TD 1708'
P mp 30 oil Pot.
38.6 Grav.
Comp July 8, 1948
Comp

COMPLETED

Map No. 17 Sec. 30 Twp. 23 R. 14E

Well No. 3 Jones

Fairway Company

FIRST REPORT

Contractor

C N L N E S W *original to be*

SECTION PLAT

330 Ft. from N. Line

 Ft. from S. Line

660 Ft. from E. Line

 Ft. from W. Line

	o		

Woodson County

Location

Rig up

Drilling and Remarks:

8" @ 40

Miss. 1668

7" @ 1668

2000 acid

30 Pot.

RECORD

Cased in., ft.

Sand

Gas

Oil ☒

Total Depth 1683

PRODUCTION

1st 24 hrs. Nat.

1st 24 hrs. after shot

Gas Cu. Ft.

Dry Hole

Abandoned

Date

JUL 8 1948 19 S. J. LEWIS Scout

Woodson County Kansas State
 Map No. 17 Sec. 30 Twp. 23 R. 14E

Well No. 3 Jones

Fairway Company

COMPLETE Contractor

C N L NE SW

SECTION PLAT

330 Ft. from N. Line

 Ft. from S. Line

660 Ft. from E. Line

 Ft. from W. Line

Miscellaneous

Remarks:

Miss. 1668 7" @ 1668 TD 1708

Pump 30 oil Pot. 38.0 gravity

Completed July 8, 1948

Date
 SEP 15 1948

Scout

S. J. LEWIS