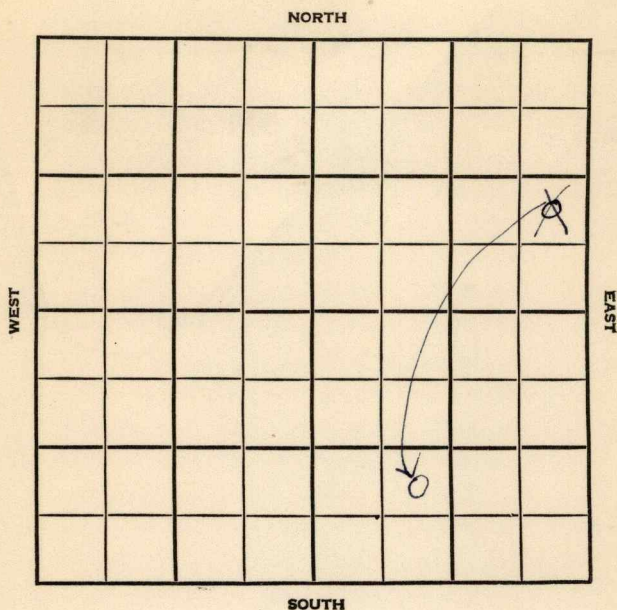


Section 3 Township 24 Range 12 EWell No. #1 SpadyCompany Cahs. Davis

GREENWOOD

KANSAS

SEC.	TWP.	R.
3	24	12E

WELL NO.

#1 Spady

FARM

COMPANY

Chas Davis

CONTRACTOR


Wildcat

Ft. from N. Line

Ft. from S. Line

Ft. from E. Line

Ft. from W. Line

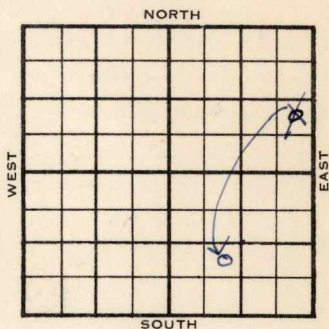SW SE
NE SE NE

1955

ELEVATION

REPORT

9/21

MICT

11-4

Comm. 11-2-55

8" @ 700

7" @ 1200

5 1/2" @ 1820

DD 1848

FU 60' oil, 14 hrs.

Comp. 50 bopd, 1 bw

M. 1m. 1813

M. dolo. 1816

TD 1848'

COMPLETED

County **Greenwood**

Elev. _____

Sec. **3**Twp. **24**Rge. **12E**Company **Chas Davis**Farm Name **Spady**No. **1**

TOPS

DEPTH

LOG

DATUM

Loc. in Sec. _____

Anh. _____

T.P. _____

H. _____

Tr. _____

Dg. _____

BL. _____

L. _____

K.C. _____

B.K.C. _____

Ce. _____

C. _____

M. _____

M. _____

K. _____

Mz. _____

Mq. _____

V. _____

S. _____

S. _____

A. _____

R. _____

Pc. _____

G. _____

T.D. _____

NE SE NE

Geol. _____

Contr. _____

Pool _____

W. C.**FIRST-REPORT****SEP 21 1955**Date Comm. **MICT**

~~CO
Y
Greenwood
Twp.
Chas. D
Spa~~

County	Greenwood	Elev.	
Sec.	3	Tw.	24
Company	Chas. Davis	Rge.	12E
Farm Name	Spady	No.	1

TOPS	DEPTH	LOG	DATUM	Loc. in Sec.
Anh.				NE SW SE
TP.				
H.				
Tr.				
Dg.				
Bl.				
L.				Geol.
K.C.				Contr.
B.K.C.				
Ce.				
C.				
M.				
M.				
K.				Pool
Mz.				(West Virgil)
Mq.				
V.				
S.				
S.				
A				
R.				
PE.				
G.				
T.D.				

Lse.

No.

CORRECTION

Date Comm.

APR 11 1956

Reported NE SE NE

Co.

Lse

No.

Sec.



County Greenwood Elev. _____
 Sec. 3 Twp. 24 Rge. 12E
 Company Chas. Davis
 Farm Name Spady No. 1

TOPS

DEPTH

LOG

DATUM

Loc. in Sec. _____

Anh. _____
 T.P. _____
 H. _____
 Tr. _____
 Dg. _____
 B.L. _____
 L. _____
 K.C. _____
 B.K.C. _____
 Ce. _____
 C. _____
 M. lyn 1813
 M. dolo 1816
 K. _____
 Mz. _____
 Mq. _____
 V. _____
 S. _____
 S. _____
 A. _____
 R. _____
 P.E. _____
 G. _____
 T.D. 1840

NE SW SE

Geol. _____

Contr. _____

Pool _____

Wildcat



Date Comm. _____

11-2-55

APR 11 1956

8" @ 700 7" @ 1200 5 1/2" @ 1820

DD 1848 FU 60' oil 1 1/4 hr.

Comp. 50 bopd 1 bw