


Map No. KANSAS Sec. 3 Twp. 24 R. 12<sup>E</sup>  
Well No. 1- Mossman Farm  
Waltom Oil Company

NORTH

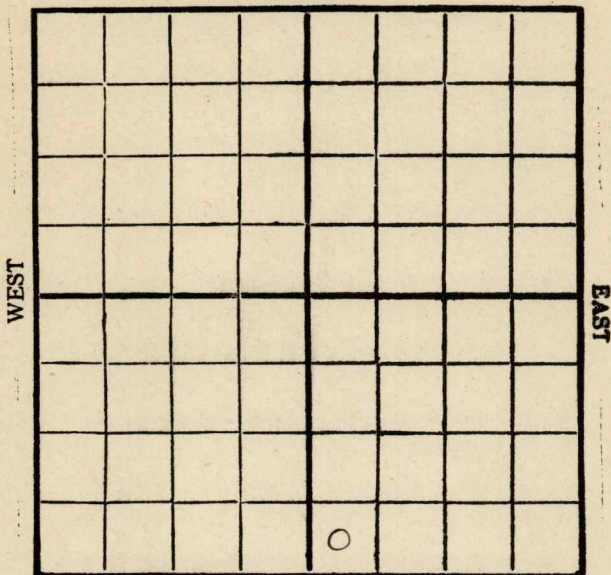

SOUTH

Location \_\_\_\_\_

Drilling Remarks

\_\_\_\_\_  
\_\_\_\_\_  
RECORD

Cased \_\_\_\_\_ in. \_\_\_\_\_ ft.

Sand \_\_\_\_\_

Gas \_\_\_\_\_

Oil \_\_\_\_\_

Total Depth \_\_\_\_\_

Rig Up \_\_\_\_\_

Drilling Remarks

\_\_\_\_\_  
\_\_\_\_\_  
PRODUCTION

1st 24 hrs. Nat. \_\_\_\_\_

1st 24 hrs. after shot \_\_\_\_\_

Gas \_\_\_\_\_ cu. ft. \_\_\_\_\_

Dry Hole \_\_\_\_\_

Abandoned \_\_\_\_\_

Map No. **KANSAS** Sec. 3 Twp. 24 R. 12

Well, No. 1 - Mossman Farm

Waltham Oil Co. Company


NORTH

Ft. from N. Line

320 Ft. from S. Line

----- Ft. from E. Line

320 Ft. from W. Line

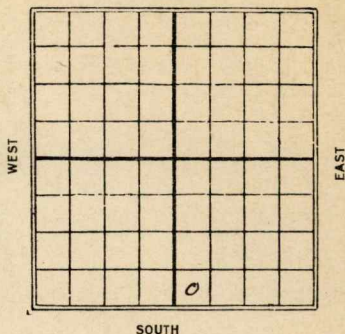

1929

Date \_\_\_\_\_

## REPORT

|      |          |
|------|----------|
| 11/6 | Location |
|------|----------|

11/13 | —

11/20

11/27  
12/4 Abandon location

|      |                  |
|------|------------------|
| 12/4 | Abandon location |
|------|------------------|

16 **KANSAS** *Greenwood*  
 Map No. \_\_\_\_\_ Sec. *3* Twp. *24* R. *12* <sup>E</sup>  
 Well No. *1* *Hessman*  
*Waltom Oil Co* \_\_\_\_\_ Company

Contractor \_\_\_\_\_

**FIRST REPORTS****SECTION PLAT**

\_\_\_\_\_ Ft. from N. Line

*320* \_\_\_\_\_ Ft. from S. Line

\_\_\_\_\_ Ft. from E. Line

*320* \_\_\_\_\_ Ft. from W. Line

|  |  |  |  |
|--|--|--|--|
|  |  |  |  |
|  |  |  |  |
|  |  |  |  |
|  |  |  |  |
|  |  |  |  |

Location \_\_\_\_\_ ✓

Rig up \_\_\_\_\_

Drilling and Remarks:

**RECORD**

Cased \_\_\_\_\_ in., \_\_\_\_\_ ft.

Sand \_\_\_\_\_

Gas \_\_\_\_\_

Oil \_\_\_\_\_

Total Depth \_\_\_\_\_

**PRODUCTION**

1st 24 hrs. Nat. \_\_\_\_\_

1st 24 hrs. after shot \_\_\_\_\_

Gas \_\_\_\_\_ Cu. Ft.

Dry Hole \_\_\_\_\_

Abandoned \_\_\_\_\_

Date

**NOV 6****1929****CHAS. L. SHERWOOD**

\_\_\_\_\_ 192\_\_\_\_\_

Scout

*Greenwood*

Map No. **KANSAS** Sec. *3* Twp. *24* R. *12*  
 Well No. *1* *Messman*  
*Walton Oil Co* Company

Contractor

**COMPLETE****SECTION PLAT**

|  |  |  |  |
|--|--|--|--|
|  |  |  |  |
|  |  |  |  |
|  |  |  |  |
|  |  |  |  |
|  |  |  |  |
|  |  |  |  |
|  |  |  |  |
|  |  |  |  |

Ft. from N. Line

*320*

Ft. from S. Line

Ft. from E. Line

*320*

Ft. from W. Line

**ABANDONED****RECORD**

Location.....

Cased..... in., ..... ft.

Rig up.....

Sand.....

Drilling and Remarks:

Gas.....

Oil.....

Total Depth.....

**PRODUCTION**

1st 24 hrs. Nat.....

1st 24 hrs. after shot.....

Gas..... Cu. Ft.

Dry Hole.....

Abandoned *Location*

Date

**DEC 4 1929****CHAS. L. SHERWOOD**

192.....

Scout