

Woodson


DX 78-1

KANSAS

Section 21 Township 23S Range 14E

Well No. #7 Shrimplin

Company B.E. French

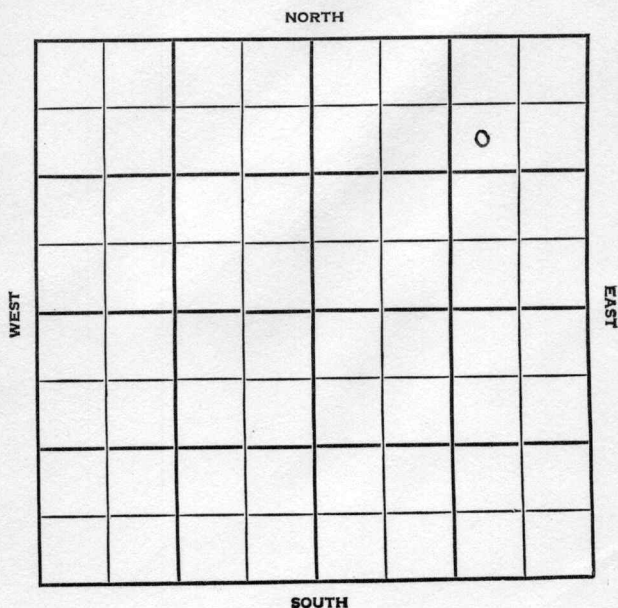

Woodson

KANSAS

SEC.	TWP.	R.
21	23 S	14 E

WELL NO.

7 Shrimplin

FARM

COMPANY

R. E. French

CONTRACTOR

Brown Drlg.


990 Ft. from N. Line

Ft. from S. Line

990 Ft. from E. Line

Ft. from W. Line

SW NE NE

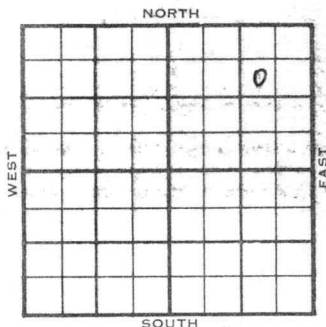

1954

ELEVATION

REPORT

12/8

Spud 12-8-54
MIM

1955

1/12

Spud 12-8-54 - Oil Well

TD 1684'

8" @ 825'

7" @ 1310'

Miss. chat 1666', Miss lime 1668'

TD 1684'


4" @ 1674'

CO to 1684 2000A

P/45 bopd

Comp. 25 bopd

COMPLETED

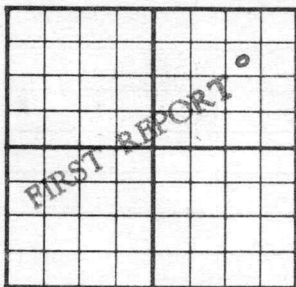County Woodson State KansasSec. 21 (Blk. 23S) (Sur. 14E) Map No.Operator R. E. FrenchWell No. 7 Farm ShrimplinElev. Location SW NE NE990 Ft. From N Line990 Ft. From E Line NE Quarter1st. Report DEC 8 1954

Completion


Remarks Brown Drlg toolsSpudding Date 12-8-54

Drlg. Data

MM

FABEN GILSTRAP

County Woodson State Kansas
 Sec. 21 (Blk.) 23 (Sur.) 14E Map No.
 Operator R. E. French
 Well No. 7 Farm Shrimplin
 Elev. _____ Location SW NE NE

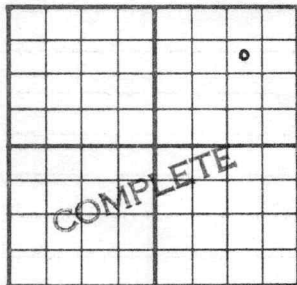

990 Ft. From N Line NE
990 Ft. From E Line Quarter

Ist. Report

Completion JAN 1 2 1955

Remarks

Brown Drllg. - Contr.

Spudding Date 12-8-54

Drllg. Data Oil well TD 1684
8" @ 825 7" @ 1310 Miss. chat 1666
Miss. lime 1668 TD 1684 4" @ 1674
CO to 1684 2000 A P/ 45 bopd
Comp. 25 bopd

FABEN GILSTRAP