


Map No. _____ Sec. 16 Twp. 27 R. 4Well No. 15 Browns Farm _____
Monitor Company _____

NORTH

WEST

EAST

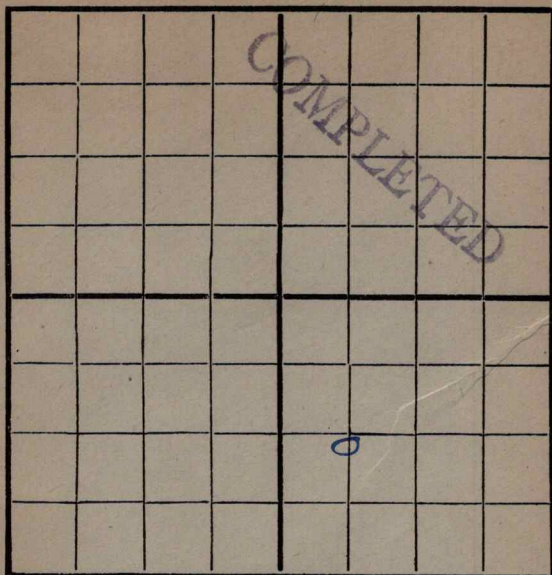

SOUTH

Location _____

Rig Up 10/30/16

Drilling Remarks:

Drilling Remarks:

R 21 = 11/9 =
Rigging Up = 11/14 =
1000 = 11/27 =
1440 = 12/4 =
2075 = 12/11 =
2300 = 12/18 =
2450 = 12/28 =

RECORD

Cased _____ in _____ Ft.
 Sand _____
 Gas _____
 Oil _____
 Total Depth _____


PRODUCTION

1st 24 hrs. Nat. _____
 1st 24 hrs. after shot _____
 Gas _____ Cu. Ft.
 Dry Hole _____
 Abandoned _____

Map No. _____ Sec. 16 Twp. 27 R. 4

Well No. 15 Brown Farm _____

Hampton Company _____

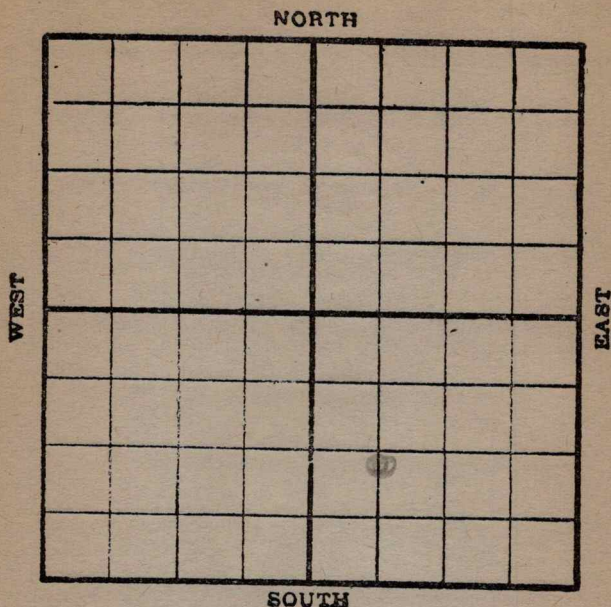

Location ✓ _____

Rig up ✓ _____

Drilling and remarks: _____

RECORD

Cased _____ in. _____ Ft.

Sand _____

Gas _____

Oil _____

Total Depth _____

PRODUCTION

1st. 24 hrs. Nat. _____

1st. 24 hrs. after shot _____

Gas _____ Cu. Ft.

Dry Hole _____


Abandoned _____

Date

10/30, 1916, LL Scout

Map No. _____ Sec. 16 Twp 22 R. 4
 Well No. 15 Brown Farm _____
Mountain Company _____

NORTH

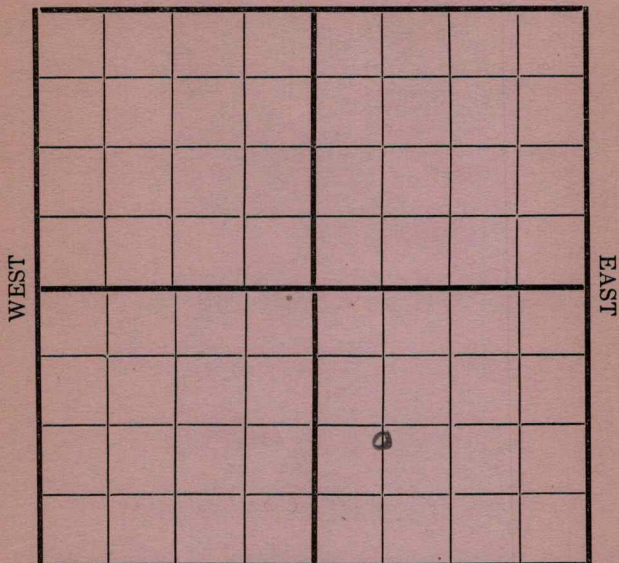

SOUTH

Location _____
 Rig Up _____
 Drilling and remarks _____

*Moving
in Pool*

RECORD

Cased _____ in. _____ Ft.
 Sand _____
 Gas _____
 Oil _____
 Total Depth _____


PRODUCTION

1st 24 hrs. Nat. _____
 1st 24 hrs. after shot _____
 Gas _____ Cu. Ft.
 Dry Hole _____
 Abandoned _____

Date 11/9, 1916 *Scout* Scout

Map No. _____ Sec. 16 Twp. 22 R. 4
 Well No. 1573 Farm _____
Union Company _____

NORTH

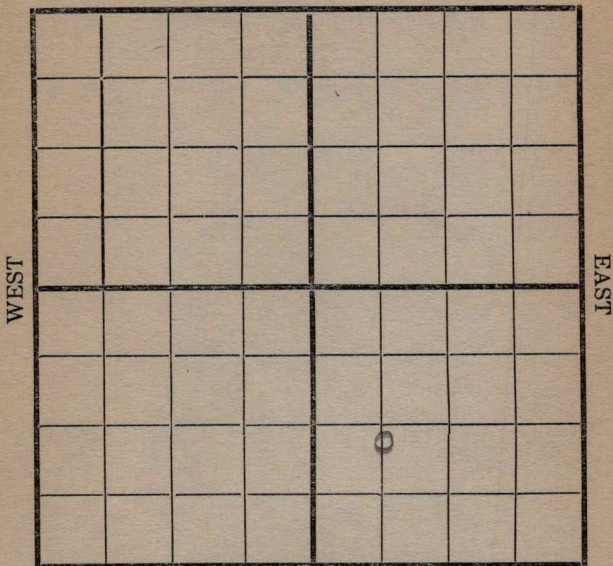

SOUTH

Location _____
 Rig Up _____
 Drilling and remarks

Rigging
up

RECORD

Cased _____ in. _____ Ft.
 Sand _____
 Gas _____
 Oil _____
 Total Depth _____

PRODUCTION

1st 24 hrs. Nat. _____
 1st 24 hrs. after shot _____
 Gas _____ Cu. Ft.
 Dry Hole _____
 Abandoned _____

Date


1/1/4 191 6 Conley Scout

Map No. _____ Sec. 16 Twp. 22 R. 4
 Well No. 15 Brown Farm _____
Union Company _____

NORTH

WEST

EAST

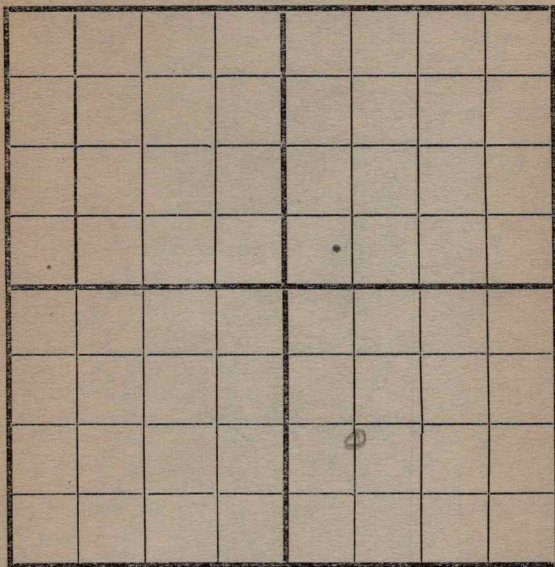

SOUTH

Location _____
 Rig Up _____
 Drilling and remarks _____

300'

RECORD

Cased _____ in. _____ Ft.
 Sand _____
 Gas _____
 Oil _____
 Total Depth _____

PRODUCTION

1st 24 hrs. Nat. _____
 1st 24 hrs. after shot _____
 Gas _____ Cu. Ft.
 Dry Hole _____
 Abandoned _____

Date

11/20, 1916 Scout

Map No. _____ Sec. 16 Twp. 27 R. 4
 Well No. 15 Brown Farm _____
Mount Company _____

NORTH

WEST

EAST

SOUTH

Location _____
 Rig Up _____
 Drilling and remarks

1000

RECORD

Cased _____ in. _____ Ft.
 Sand _____
 Gas _____
 Oil _____
 Total Depth _____

PRODUCTION

1st 24 hrs. Nat. _____
 1st 24 hrs. after shot _____
 Gas _____ Cu. Ft.
 Dry Hole _____
 Abandoned _____

Date

4/22, 1916 Candy Scout

Map No. _____ Sec. 16 Twp. 27 R. 4Well No. 15 Brown Farm _____Company Moniteau _____

NORTH

WEST

EAST

SOUTH

Location _____

Rig Up _____

Drilling and remarks

RECORD

Cased _____ in. _____ Ft.

Sand _____

Gas _____

Oil _____

Total Depth _____

PRODUCTION

1st 24 hrs. Nat. _____

1st 24 hrs. after shot _____

Gas _____ Cu. Ft.

Dry Hole _____

Abandoned _____

Date


12/4, 1916, Cordiff Scout

Map No. _____ Sec. 16 Twp. 27 R. 4Well No. 15 Brown Farm _____
Monitor Company _____

NORTH

WEST

EAST

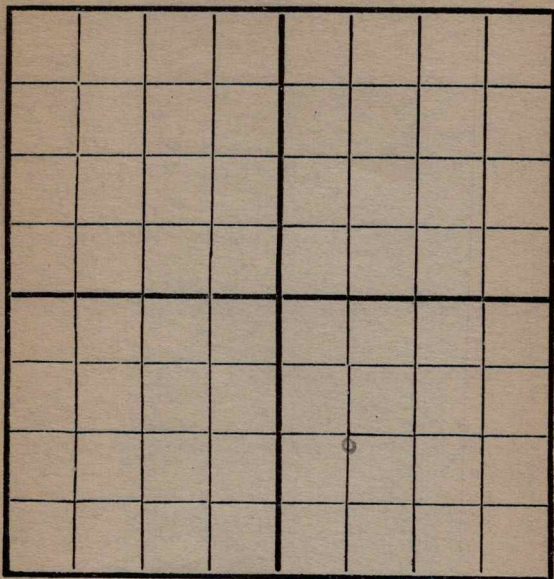

SOUTH

RECORD

Location _____

Cased _____ in. _____ Ft.

Rig Up _____

Sand _____

Drilling and remarks

Gas _____

2075'

Oil _____

Total Depth _____

PRODUCTION

1st 24 hrs. Nat. _____

1st 24 hrs. after shot _____

Gas _____ Cu. Ft.

Dry Hole _____

Abandoned _____

Date


12/11, 1916, Candiff Scout

Map No. _____ Sec. 16 Twp. 27 R. 4Well No. 1513 Brown Farm __________
Company _____

NORTH

WEST

EAST

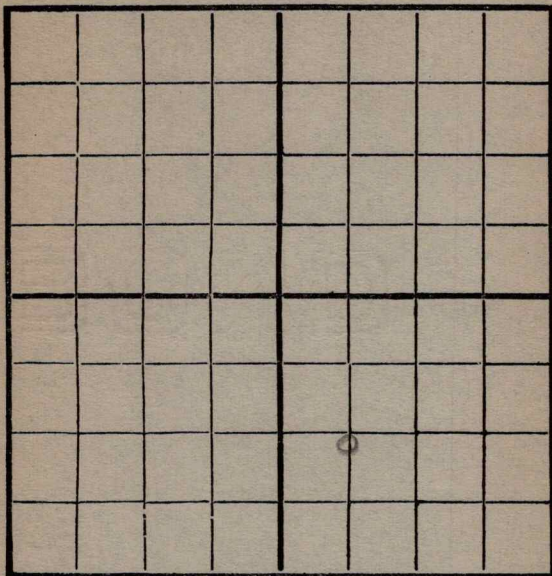

SOUTH

RECORD

Location _____

Cased _____ in. _____ Ft.

Rig Up _____

Sand _____

Drilling and remarks

Gas _____

Oil _____

Total Depth _____

2300'

PRODUCTION

1st 24 hrs. Nat. _____

1st 24 hrs. after shot _____

Gas _____ Cu. Ft.


Dry Hole _____

Abandoned _____

Date

12/18, 1916B. C. Dwyer Scout

Map No. _____ Sec. 16 Twp. 27 R. 4
 Well No. 15 Brown Farm _____
Mountain Company

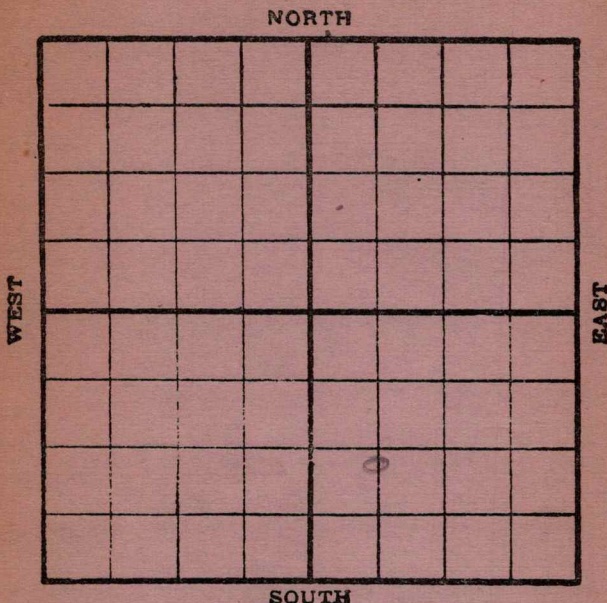

Location _____
 Rig up _____
 Drilling and remarks:

2450

RECORD

Cased _____ in. _____ Ft.
 Sand _____
 Gas _____
 Oil _____
 Total Depth _____

PRODUCTION


1st. 24 hrs. Nat. _____
 1st. 24 hrs. after shot _____
 Gas _____ Cu. Ft.
 Dry Hole _____
 Abandoned _____

Date 12/28/28 1916, C. C. Jeff Scout

Map No. _____ Sec. 16 Twp. 27 R. 4
 Well No. 15 Brown Farm _____
Monitor Company _____

NORTH

WEST

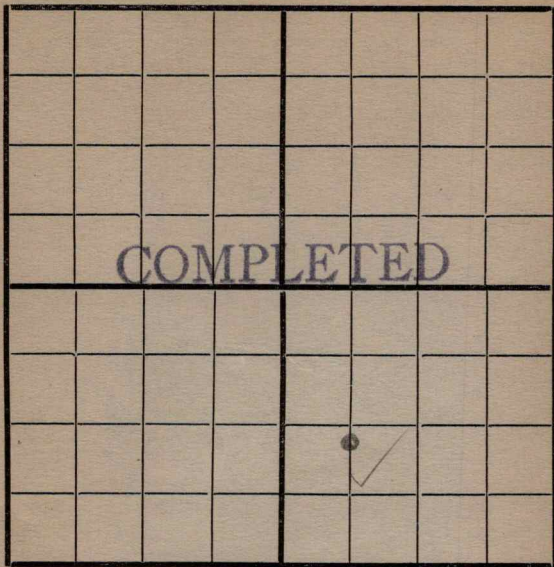

EAST

SOUTH

Location _____
 Rig Up _____
 Drilling and remarks _____

*Estimated
 good for
 300 Bbls*

RECORD

Cased _____ in. _____ Ft.
 Sand 2462-2524
 Gas _____
 Oil _____
 Total Depth _____

PRODUCTION

1st 24 hrs. Nat. _____
 1st 24 hrs. after shot _____
 Gas _____ Cu. Ft.
 Dry Hole _____
 Abandoned _____

Date

1/1, 191 7 Academy Scout