


Section 4 Township 24 Range 12E

Well No. #1 Ulrick

Company W.A. Cameron

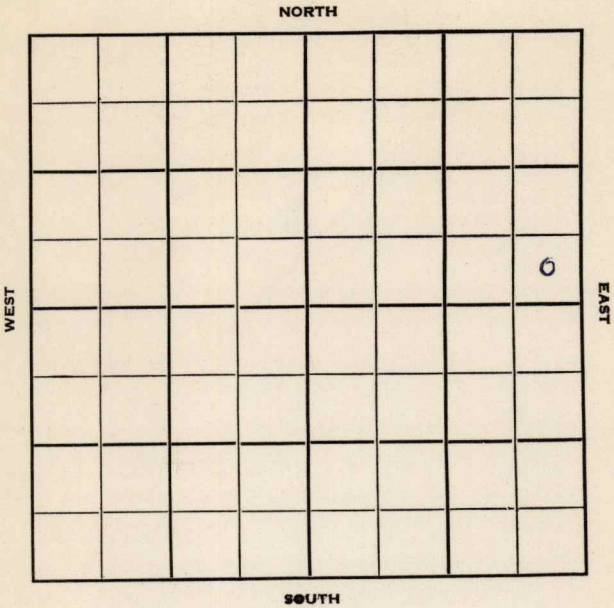

Greenwood **KANSAS**

Sec. 4 Twp. 24 R. 12E ✓

Well No. #1 Ulrick Farm

W. A. Cameron Company

Barker Drlg. - Contr. Contractor
Wildcat


 Ft. from N. Line

330' Ft. from S. Line

330' Ft. from E. Line

 Ft. from W. Line

SE SE NE

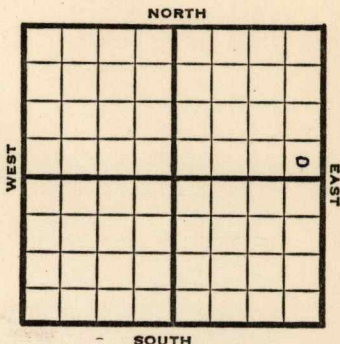

1950

Elev. -

REPORT

12/6

Drl g. 610'

12/27

D&A TD 1830

10" @ 672

Miss 1798

TD 1830

D&A

ABANDONED

County Greenwood State Kansas
Sec. 4 (Blk.) 24 (Sur.) 12E Map No.
Operator W. A. Cameron
Well No. 1 Farm Ulrick
Elev. Location SE SE NE

330 Ft. From S Line NE
330 Ft. From E Line Quarter

1st. Report DEC 6 1950

Completion

Remarks

Barker - Contr.


Spudding Date

Drlg. Data

Wildcat

drlg. 610

J. E. TYRA

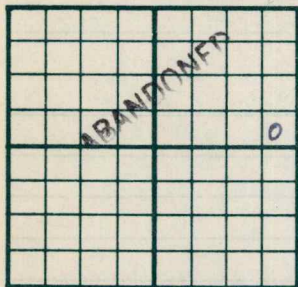County Greenwood State KansasSec. 4 (Blk.
Twp.) 24 (Sur.
Rge.) 12E Map No.Operator W. A. CameronWell No. 1 Farm UlrickElev. Location SE SE NE330 Ft. From S Line NE330 Ft. From E Line Quarter

1st. Report

Completion DEC 27 1950Remarks WildcatBarker - Contr.

Spudding Date

Drlg. Data D & A TD 183010" @ 672 Miss. 1798 TD 1830D & A

J. E. TYRA