


Map No. _____ Sec. 16 Twp. 27 R. 4Well No. 16 Brown Farm __________Monitor_____
Company

NORTH

WEST

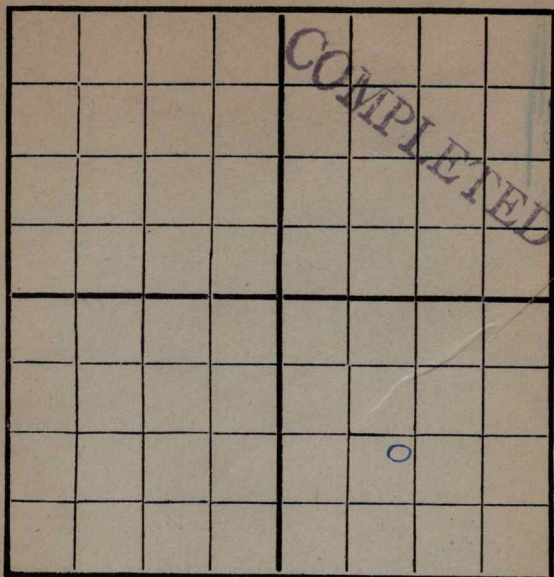

EAST

SOUTH

Location _____

Rig Up 10/30/16

Drilling Remarks:

Drilling Remarks:

921: 11/9500: 11/14550: 11/27800: 12/41100: 12/11 = F1600: 12/181840: 12/28

RECORD

PRODUCTION

Cased _____ in _____ Ft.

Sand _____

Gas _____

Oil _____

Total Depth _____

1st 24 hrs. Nat. _____

1st 24 hrs. after shot _____

Gas _____ Cu. Ft.


Dry Hole _____

Abandoned _____

Map No. _____ Sec. 16 Twp. 27 R. 4

Well No. 16 Brown Farm

Morinton Company

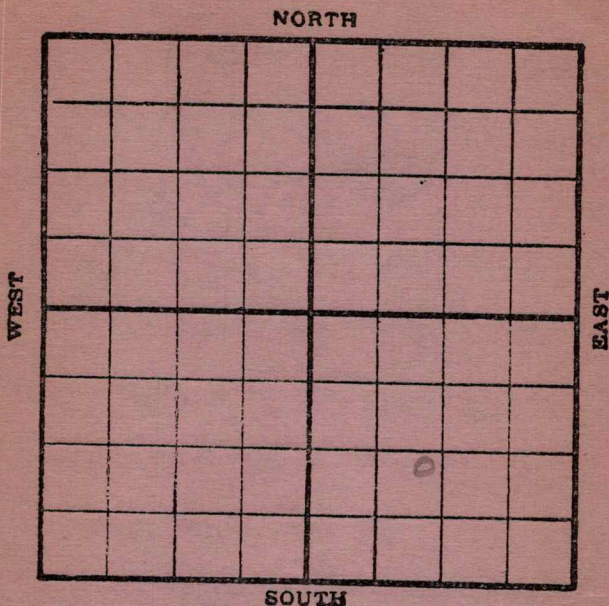

Location _____

Rig up ☒ _____

Drilling and remarks:

RECORD

Cased _____ in. _____ Ft.

Sand _____

Gas _____

Oil _____

Total Depth _____

PRODUCTION

1st. 24 hrs. Nat. _____

1st. 24 hrs. after shot _____

Gas _____ Cu. Ft.

Dry Hole _____


Abandoned _____

Date

10/30, 1916, SCC Scout

Map No. _____ Sec. 16 Twp. 27 R. 4
 Well No 16 Brown Farm _____
Monitor Company _____

NORTH

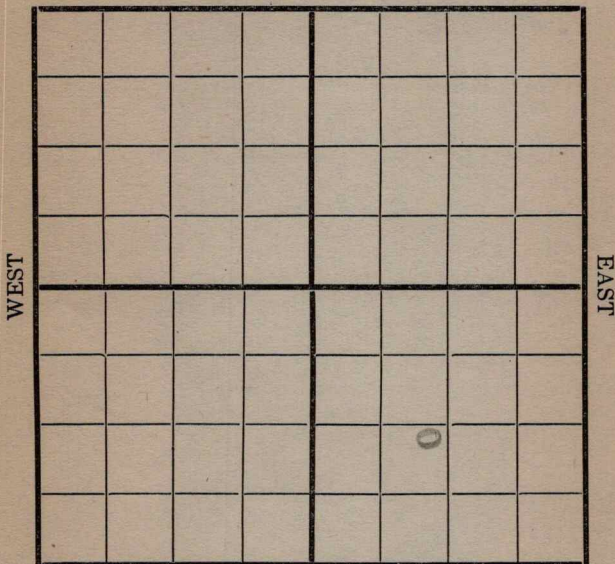

SOUTH

Location _____
 Rig Up _____
 Drilling and remarks _____

*Moving in
 Tools*

RECORD

Cased _____ in. _____ Ft.
 Sand _____
 Gas _____
 Oil _____
 Total Depth _____

PRODUCTION

1st 24 hrs. Nat. _____
 1st 24 hrs. after shot _____
 Gas _____ Cu. Ft.
 Dry Hole _____
 Abandoned _____

Date


1/9, 1916 *Scout* Scout

Map No. _____ Sec. 16 Twp. 27 R. 4
 Well No. 16 Brown Farm _____
Monitor Company

NORTH

WEST

EAST

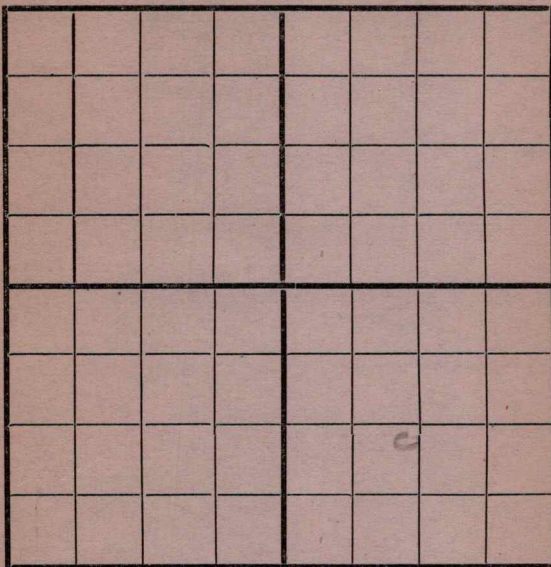

SOUTH

Location _____
 Rig Up _____
 Drilling and remarks _____

RECORD

Cased _____ in. _____ Ft.
 Sand _____
 Gas _____
 Oil _____
 Total Depth _____

PRODUCTION

1st 24 hrs. Nat. _____
 1st 24 hrs. after shot _____
 Gas _____ Cu. Ft.
 Dry Hole _____
 Abandoned _____

Date

191

Scout

Map No. _____ Sec. 16 Twp. 27 R. 4Well No. 16 Brown Farm __________Mountain Company _____

NORTH

WEST

EAST

SOUTH

Location _____

Rig Up _____

Drilling and remarks

200

RECORD

Cased _____ in. _____ Ft.

Sand _____

Gas _____

Oil _____

Total Depth _____

PRODUCTION

1st 24 hrs. Nat. _____

1st 24 hrs. after shot _____

Gas _____ Cu. Ft.

Dry Hole _____

Abandoned _____

Date


11/20, 1916 Condyss Scout

Map No. _____ Sec. 16 Twp. 27 R. 4
 Well No. 16 Brown Farm _____
Union Company _____

NORTH

WEST

EAST

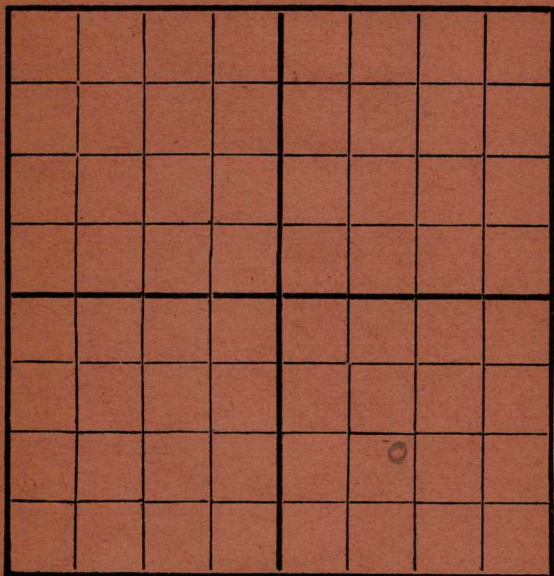

SOUTH

Location _____
 Rig Up _____
 Drilling and remarks

550

RECORD

Cased _____ in. _____ Ft.
 Sand _____
 Gas _____
 Oil _____
 Total Depth _____

PRODUCTION

1st 24 hrs. Nat. _____
 1st 24 hrs. after shot _____
 Gas _____ Cu. Ft.
 Dry Hole _____
 Abandoned _____


Date 11/27, 191 8 Scout Conley

Map No. _____ Sec. 16 Twp. 27 R. 4
 Well No. 16 Brown Farm _____
Monitor Company _____

NORTH

WEST

EAST

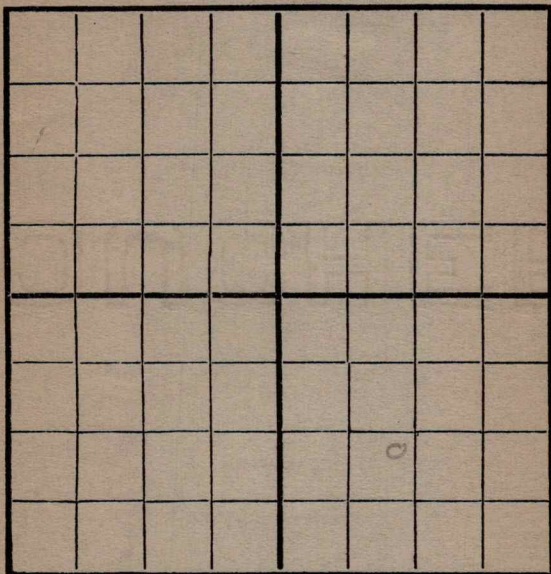

SOUTH

Location _____

Rig Up _____

Drilling and remarks

800'

RECORD

Cased _____ in. _____ Ft.

Sand _____

Gas _____

Oil _____

Total Depth _____

PRODUCTION

1st 24 hrs. Nat. _____

1st 24 hrs. after shot _____

Gas _____ Cu. Ft.

Dry Hole _____

Abandoned _____

Date

12/4, 1916, Cordiff Scout


Map No. _____ Sec. 16 Twp. 27 R. 4Well No. 16 Brown Farm _____

Company _____

NORTH

WEST

EAST

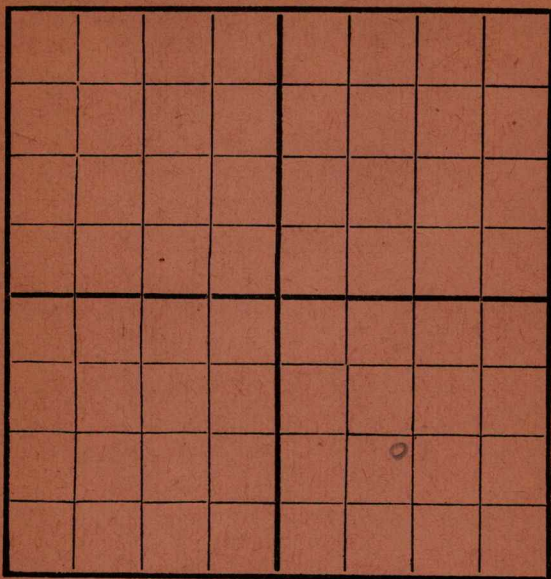

SOUTH

RECORD

Location _____

Cased _____ in. _____ Ft.

Rig Up _____

Sand _____

Drilling and remarks

Gas _____

Oil _____

Total Depth _____

PRODUCTION

1st 24 hrs. Nat. _____

1st 24 hrs. after shot _____

Gas _____ Cu. Ft.

Dry Hole _____

Abandoned _____

Date


12/11, 1916

Scout

Map No. _____ Sec. 16 Twp. 27 R. 4
 Well No. 16 Brown Farm _____
Union Company _____

NORTH

WEST

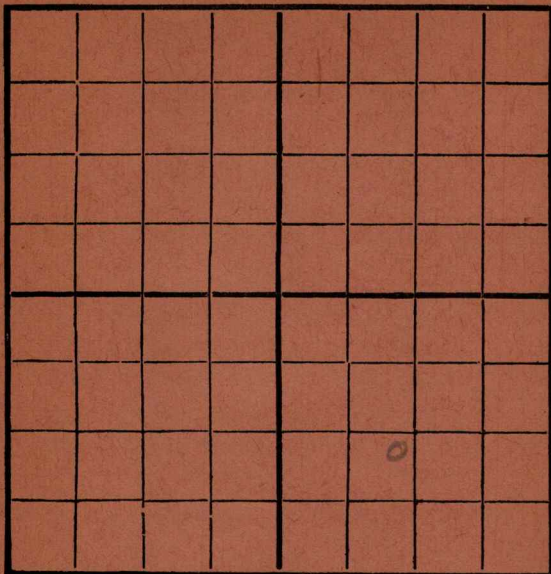

EAST

SOUTH

Location _____
 Rig Up _____
 Drilling and remarks _____

1600'

RECORD

Cased _____ in. _____ Ft.
 Sand _____
 Gas _____
 Oil _____
 Total Depth _____

PRODUCTION

1st 24 hrs. Nat. _____
 1st 24 hrs. after shot _____
 Gas _____ Cu. Ft.
 Dry Hole _____
 Abandoned _____

Date

12/18, 1916 C. Condit Scout


Map No. _____ Sec. 16 Twp. 27 R. 4

Well No. 16 Brown Farm

Wesington Company

NORTH

WEST

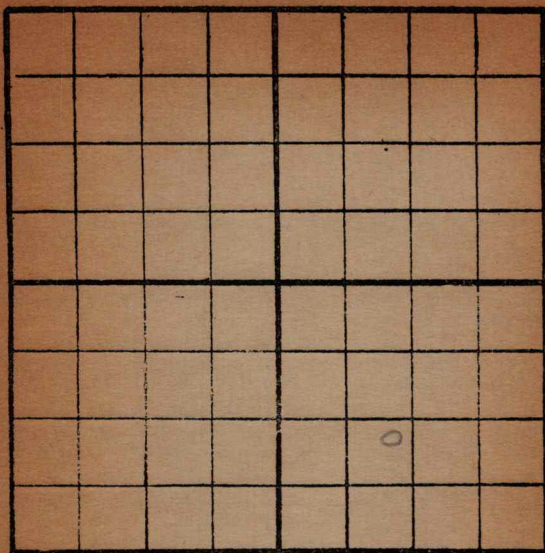

EAST

SOUTH

Location _____

Rig up _____

Drilling and remarks:

1840

RECORD

Cased _____ in. _____ Ft.

Sand _____

Gas _____

Oil _____

Total Depth _____

PRODUCTION

1st. 24 hrs. Nat. _____

1st. 24 hrs. after shot _____

Gas _____ Cu. Ft.

Dry Hole _____


Abandoned _____

Date

12/28, 1916, C. C. Coffey Scout

Map No. _____ Sec. 16 Twp. 27 R. 4
 Well No. 16 Brown Farm _____
Uniontown Company _____

NORTH

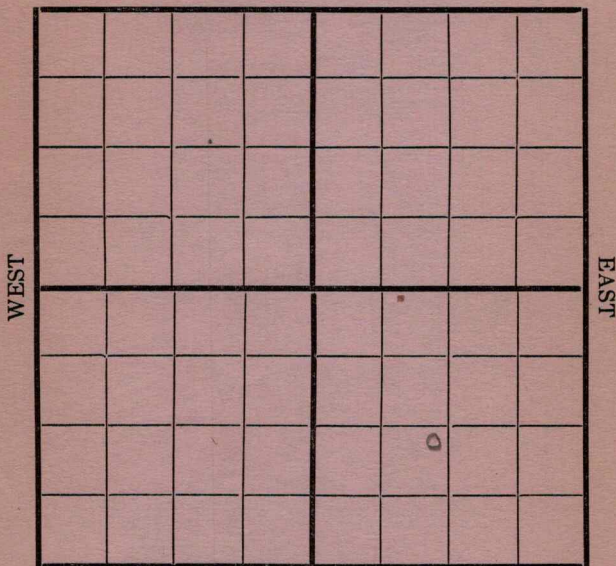

SOUTH

Location _____
 Rig Up _____
 Drilling and remarks _____

2210'

RECORD

Cased _____ in. _____ Ft.
 Sand _____
 Gas _____
 Oil _____
 Total Depth _____

PRODUCTION

1st 24 hrs. Nat. _____
 1st 24 hrs. after shot _____
 Gas _____ Cu. Ft.
 Dry Hole _____
 Abandoned _____


Date

1/1, 1917 Paul G. Scout

Map No. _____ Sec. 16 Twp. 27 R. 4Well No. 16 Brown Farm
Monitor Company

NORTH

WEST

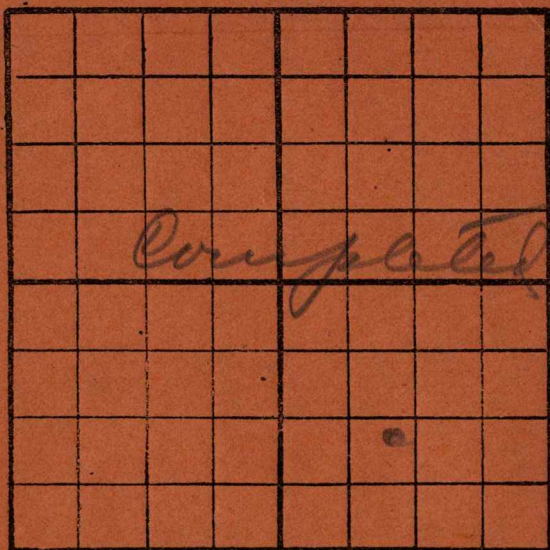

EAST

SOUTH

Location _____

Rig up _____

Drilling and remarks:

RECORD

Cased _____ in. _____ Ft.

Sand 2418-2450

Gas _____

Oil _____

Total Depth _____

PRODUCT

1st. 24 hrs

1st. 24 hrs

Gas

Date

1/8, 1917