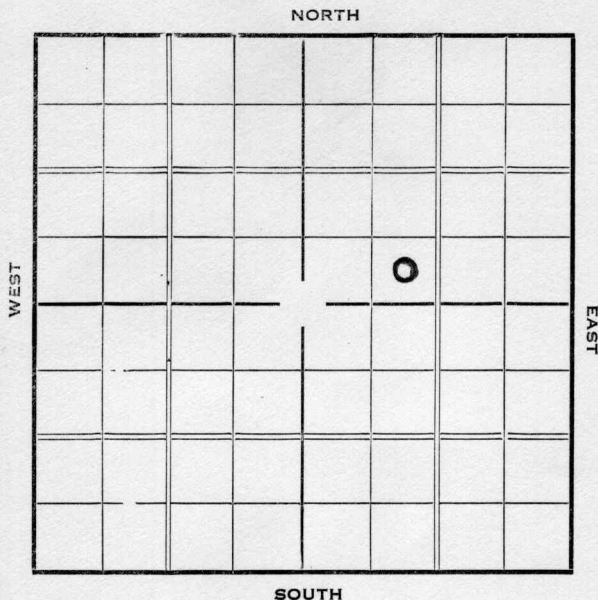
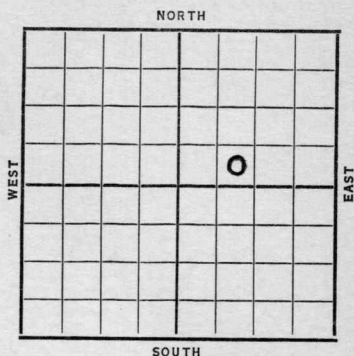


Section 22 Township 23 Range 14-EWell Number 1 - unkCompany Anexander et al

Sec. 22 Twp. 23 R. 14-EWell No. #1 Funk FarmAlexander et al Company Ft. from N. Line330 Ft. from S. Line Ft. from E. Line990 Ft. from W. Line

Date

REPORT

1937

5/5

Machine.

Spudding.

5/14

10" @ 996'. ϕ 830'.

5/21

Miss. 1636'. T.D. 1646'.

6" @ 1636'. WOC.

5/26

6" @ 1636'.

Miss. 1636'.

T.D. 1646'.

3000 A

Pot . 119 bbls.

COMPLETED

Woodson

KANSAS

Map No. 17 Sec. 22 Twp. 23 R. 14^EWell No. 1 - JunkAlexander et al Company

Contractor

FIRST REPORT

SECTION PLAT

		0	

_____ Ft. from N. Line

330 Ft. from S. Line

_____ Ft. from E. Line

990 Ft. from W. Line

Location _____

Rig up _____

Drilling and Remarks:

machine
spudding

RECORD

Cased _____ in., _____ ft.

Sand _____

Gas _____

Oil _____

Total Depth _____

PRODUCTION

1st 24 hrs. Nat. _____

1st 24 hrs. after shot _____

Gas _____ Cu. Ft.

Dry Hole _____

Abandoned _____

Date

MAY 5 - 1937 19

H. D. Hatfield Scout

KANSAS

Woodson

Map No. 17 Sec. 22 Twp. 23 R. 14 ^EWell No. 1-FunkAlexander et al Company

Contractor

COMPLETED

SECTION PLAT

 Ft. from N. Line330 Ft. from S. Line Ft. from E. Line990 Ft. from W. LineLocation Rig up

Drilling and Remarks:

3000 APot - 119

RECORD

Cased 6 in., 1636 ft.Sand MISS 1636Gas Oil Total Depth 1646

PRODUCTION

1st 24 hrs. Nat. 1st 24 hrs. after shot Gas Cu. Ft.Dry Hole Abandoned

Date

MAY 26 1937 19

H. D. Hatfield

Scout