

KANSAS

Woodson

Section 22 Township 23 Range 14-E

Well No. #2 McGuire

Company C C Vannocker
Miscellaneous

NORTH

WEST

	0						

EAST

SOUTH

Woodson

KANSAS

Sec. 22 Twp. 23 R. 14E

Well No. #2 McGuire Farm

C. C. Vannocker Company

Contractor

Miscellaneous


Ft. from N. Line

330' Ft. from S. Line

Ft. from E. Line

990' Ft. from W. Line

SE SW NW

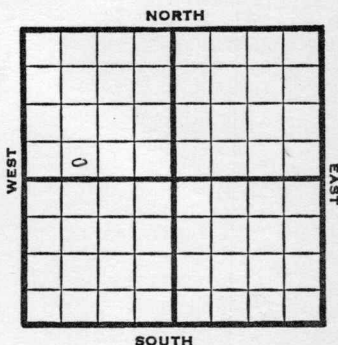

1950

REPORT

3/1 Spud 2-23-50

10" @ 20'

Drilg. 525'

3/15 TD 1681'

10" @ 20'

8" @ 828'

Miss 1645'

D&A

Aband.

ABANDONED

Kansas

Miscellaneous

Map No. _____ Sec. 22 Twp. 23 R. 14EWell No. 2 McGuire_____C. C. Vannocker_____
Company_____
Contractor

SE SW NW

SECTION PLAT

_____Ft. from N. Line330 Ft. from S. Line_____Ft. from E. Line990 Ft. from W. LineWoodson County

Location _____

Rig up _____

Drilling and Remarks:

Spud 2-23-5010" @ 20drlg. 525

RECORD

Cased _____ in., _____ ft.

Sand _____

Gas _____

Oil _____

Total Depth _____

PRODUCTION

1st 24 hrs. Nat. _____

1st 24 hrs. after shot _____

Gas _____ Cu. Ft.

Dry Hole _____

Abandoned _____

Date

MAR 1 1950 19J. E. TYRAScout

Kansas

Map No. _____ Sec. 22 Twp. 23 R. 14EWell No. 2 McGuire

C. C. Vannocker

Company

Contractor

SE SW NW

SECTION PLAT

_____ Ft. from N. Line

330 Ft. from S. Line

_____ Ft. from E. Line

990 Ft. from W. Line

Woodson County

Location _____

Rig up _____

Drilling and Remarks:

10" @ 208" @ 828miss 1645D + A

RECORD

Cased _____ in., _____ ft.

Sand _____

Gas _____

Oil _____

Total Depth 1681

PRODUCTION

1st 24 hrs. Nat. _____

1st 24 hrs. after shot _____

Gas _____ Cu. Ft.

Dry Hole _____

Abandoned _____

Date

MAR 15 1950

19

J. E. TYRA

Scout