


Map No. *Greenwood* **KANSAS** Sec. *5* Twp. *24* R. *12^E*

Well No. *1-Morris* Farm

Senhour et al Company

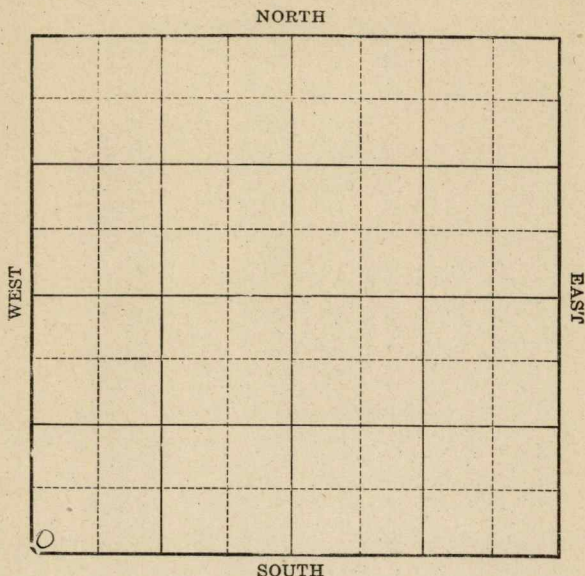

Location _____

Drilling Remarks _____

Rig Up _____

Drilling Remarks _____

RECORD

Cased _____ in. _____ ft.

Sand _____

Gas _____

Oil _____

Total Depth _____

PRODUCTION

1st 24 hrs. Nat. _____

1st 24 hrs. after shot _____

Gas _____ cu. ft.

Dry Hole _____


Abandoned _____

Map No. **KANSAS** Sec. 5 Twp. 24 R. 12^E

Well No. 1-Morris Farm

Senhour et al Company

NORTH

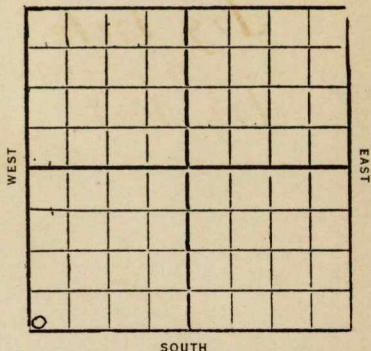

Ft. from N. Line

75 Ft. from S. Line

Ft. from E. Line

75 Ft. from W. Line

1932

Date

REPORT Twin to Ø

7/13	Machine
7/20	drdg 300'
7/27	dsq 690'
8/3	dsq 780'
8/10	drdg 835'
8/17	" 1075'
8/24	" 1290'
8/31	Land 1725-39
	TD 1742½
	400' oil in hole
	Well shoot
9/7	TD 1742½
	shot 60 qt
	800' oil in hole
	Clg out
9/14	TD 1742½ On pump
	No test
9/21	Land 1725-39
	TD 1742½
	shot 60 qt
	Pump 50 bbl oil
	Comp.

16 **KANSAS** *Greenwood* *E*
 Map No. _____ Sec. *5* Twp. *24* R. *12*
 Well No. *1* *Meris*

Senhew Ct A1 _____ Company
 _____ Contractor

FIRST REPORTS

_____ Ft. from N. Line

75 _____ Ft. from S. Line

_____ Ft. from E. Line

75 _____ Ft. from W. Line

SECTION PLAT

Join To Dry Hole.

Location _____

Rig up *Machine* _____

Drilling and Remarks:

RECORD

Cased _____ in., _____ ft.

Sand _____

Gas _____

Oil _____

Total Depth _____

PRODUCTION

1st 24 hrs. Nat. _____

1st 24 hrs. after shot _____

Gas _____ Cu. Ft.

Dry Hole _____

Abandoned _____

Date


JUL 13 1932 **CHAS. L. SHERWOOD**
 _____ 192 _____ Scout

Is this TWIN Well to
dry hole

Sum

Yes, Twin to Dry
Hole.

C. R. D.

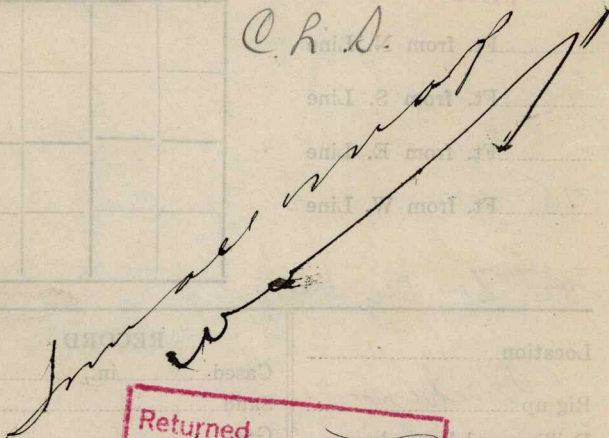

Returned	
Cards	
Tracing	<i>JWS.</i>
France Map	<i>JWS.</i>
Scarborough Map	
Moody Map	
Scarborough Plat Book	
Moody Plat Book	

16 **KANSAS** Sec. 5 Twp. 24 R. 12

Well No. 1 Morris

Senhew Oil Co. Company

Contractor

COMPLETED

SECTION PLAT

Ft. from N. Line

75 Ft. from S. Line

Ft. from E. Line

75 Ft. from W. Line

Location

Rig up

Drilling and Remarks:

Shot 60'

Pump 50 Bbl.

RECORD

Cased in, ft.

Sand 17 25-17 39

Gas

Oil

Total Depth 17 4 2 1/2

PRODUCTION

1st 24 hrs. Nat.

1st 24 hrs. after shot

Gas Cu. Ft.

Dry Hole

Abandoned

Date

SEP 2 1 1932

192

CHAS. L. SHERWOOD

Scout