


Greenwood.

DX 78-1

KANSAS

Section 5 Township 24S Range 12E
Well No. #9 #1 Beuchat (Beauchat)
Company Arthur Luke

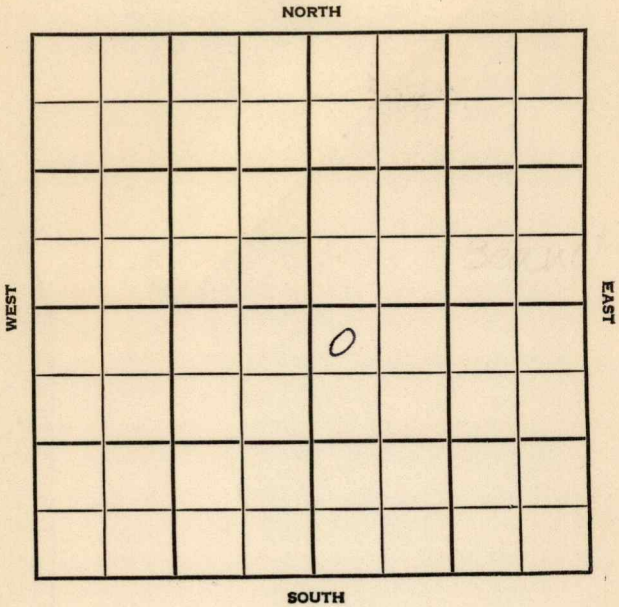

Greenwood KANSAS

SEC.	TWP.	R.
5	24S	12E

WELL NO.

9 X Beuchat

FARM

COMPANY

Arthur Lyke

CONTRACTOR


Baker Tools

330 Ft. from N. Line

Ft. from S. Line

Ft. from E. Line

330 Ft. from W. Line

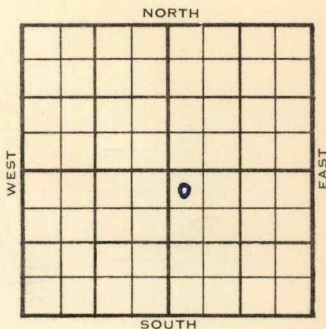

NW NW SE

	ELEVATION	REPORT
1954		

12/8

Spdg.

1955

1/26

Spud 12-6-54

Oil Well

TD 1615'

8" @ 1395'

Cattleman Sd. 1572'

TD 1615'

7" @ 1572'

CO to 1615' FU 500' oil

Comp 11 bopd. 2 bw.

COMPLETED

County Greenwood State KansasSec. 5 (Blk.) 24S (Sur.) 12E Map No.Operator Arthur LykeWell No. 1 Farm BouchatElev. Location NW NW SE

330 Ft. From N Line330 Ft. From W Line SE Quarter1st. Report DEC 8 1954

Completion

Remarks Baker tools

Spudding Date

Drlg. Data

Spdg

FABEN GILSTRAP

SCOUT TICKET

DX-201

K 111111

SEC.

TWP.

R.

5

24

12E

WELL NO.

9 Beuchat

FARM

COMPANY

Arthur Luke

CONTRACTOR

CORRECTION

NW NW SE

330

FT. FROM N. LINE


FT. FROM S. LINE

FT. FORM E. LINE

330

FT. FROM W. LINE

NORTH

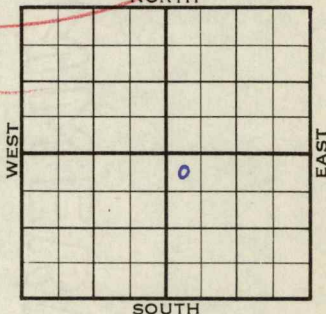

SOUTH

Greenwood County

☐ LOCATION	RECORD	CASED	IN.,	FT.
☐ RIG UP		SAND		
DRILLING AND REMARKS:		GAS		
		OIL		
		TOTAL DEPTH		
Reported #1 Beuchat	PRODUCTION	1ST 24 HRS. NAT.		
		1ST 24 HRS. AFTER SHOT		
		GAS		CU. FT.
		DRY HOLE		
		ABANDONED		

DATE

SCOUT

JAN 26 1955

FABEN GILSTRAP

County Greenwood State Kansas
 Sec. 5 (Blk.) 24 (Sur.) 12E Map No.
 Operator Arthur Luke
 Well No. 9 Farm Beuchat
 Elev. _____ Location NW NW SE



330 Ft. From N Line SE
330 Ft. From W Line Quarter

1st. Report _____

Completion JAN 2 6 1955

Remarks _____

Baker - Contr.

Spudding Date 12-6-54

Drlg. Data Oil well TD 1615

8" @ 1395 Cattleman sd. 1572

TD 1615 7" @ 1572 CO to 1615

FU 500' oil Comp. 11 bopd 2 bw

FABEN GILSTRAP