

Greenwood

KANSAS

SECTION 5 TOWNSHIP 24 RANGE 12E

WELL NO. #10 Beuchat (Beauchat)

COMPANY Arthur Lyke

NORTH

				0			

WEST

EAST

SOUTH

Greenwood

KANSAS

SEC.	TWP.	R.
5	24	12E

WELL NO.

#10 Beuchat

FARM

COMPANY

Arthur Lyke

CONTRACTOR

Baker

Hamilton


_____ Ft. from N. Line

_____ Ft. from S. Line

_____ Ft. from E. Line

_____ Ft. from W. Line

NW SW SE

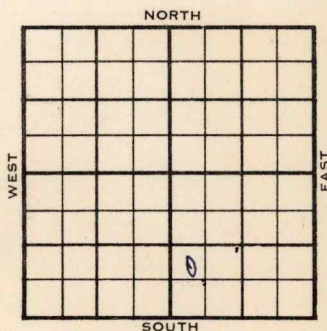

1956

ELEVATION

REPORT

4-4

10" @ 23
Orlg. 312

4-25

8 5/8" @ 653
5 1/2" @ 1605
P/ 20 BOPD, no wtr.
CO 1650
Cahle 1605
TD 1650'

COMPLETED

County Greenwood Elev. _____
Sec. 5 Twp. 24 Rge. 12E
Company Arthur Lyke
Farm Name Bouchat No. 10

TOPS	DEPTH	LOG	DATUM	Loc. in Sec.
Anh.				NW SW SE
Tr.				
H.				
Tr.				
Dg.				
Bl.				
L.				Geol. _____
K.C.				Contr. _____
B.K.C.				Baker
Ce.				
C.				
M.				Pool
M.				Hamilton
K.				
Mz.				
Mo.				
V.				
S.				
S.				
A.				
R.				
Pe.				
G.				
T.D.				

FIRST REPORT

APR 4 '56

0

Date Comm. 10" @ 23 drlg. 312

APR 10 1956

8

County Greenwood Elev. _____
 Sec. 5 Twp. 2h Rge. 12E
 Company Arthur Lyke
 Farm Name Beuchat No. 10

TOPS	DEPTH	LOG	DATUM	Loc. in Sec.
Anh.				
Tp. <u>CoHle</u>	<u>1605</u>			<u>NW SW SE</u>
H. <u>Bartford</u>	<u>1605</u>			
Tr.				
Dg.				
BL.				
L.				
K.C.				Geol. _____
B.K.C.				Contr. _____
Ce.				<u>Baker</u>
C.				
M.				Pool _____
M.				<u>Hamilton</u>
K.				
Mz.				
Me.				
V.				
S.				
S.				
A.				
R.				
Pe.				
G.				
TD.	<u>1650</u>			

COMPLETE

Date Comm. 3-31-56 APR 25 1956

10" @ 23 drls. 372. APR 11 '56 8 5/8 653

10" 1072 APR 18 '56 5 1/2 @ 1605 APR 25 '56

Pop. P. 20 Bopd no/wt
(CO ~~160~~ 1650)