

KANSAS


FORM 51 5M 6-46 PETROL

Woodson County

Section 22 Township 23 Range 14E

Well No. 2 Funk

Company T. C. Craig et al

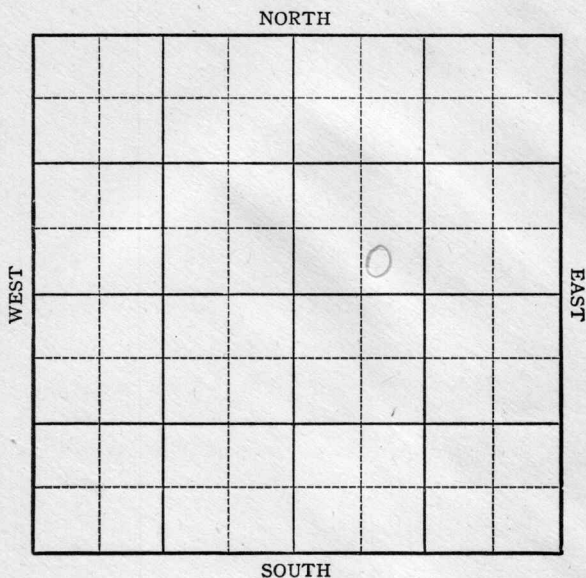

KANSAS

Woodson County ✓

Sec. 22 Twp. 23 R. 14EWell No. #2 Funk Farm

T. C. Craig et al Company

Miscellaneous


Ft. from N. Line

330 Ft. from S. Line

Ft. from E. Line

830 Ft. from W. Line

SE SW NE

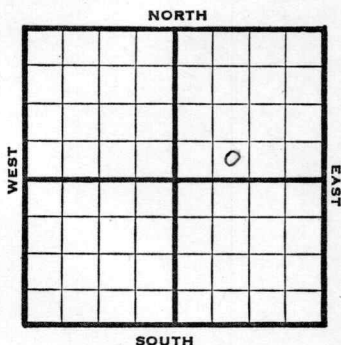

1946

REPORT

8/7	Spud
8/13	815 run 10"
8/20	8" @ 1200 Drlg 1275'
8/27	10" @ 805 Drlg 1420'
9/5	Miss 1639 TD 1650' 6" @ 1639 WOC
9/10	" "
9/18	1000 acid Pump 3 oil plus W recement
9/24	" " "
10/2	Miss 1639' 6" @ 1639' 1000 Acid TD 6150' Pump 6 POT Grav 38

COMPLETED


KANSAS **Kansas** Pool Name Miscellaneous
 Map No. 7 Sec. 22 Twp. 23 R. 14E
 Well No. 2 Funk

T. C. Craig et al. Company

FIRST REPORT Contractor

SE SW NE

SECTION PLAT

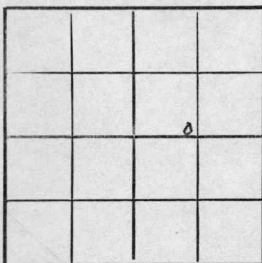

 Ft. from N. Line

330 Ft. from S. Line

 Ft. from E. Line

830 Ft. from W. Line

Woodson County

Location

Rig up

Drilling and Remarks:

Spud

RECORD

Cased in., ft.

Sand

Gas

Oil

Total Depth

PRODUCTION

1st 24 hrs. Nat.

1st 24 hrs. after shot

Gas Cu. Ft.

Dry Hole

Abandoned

Date

AUG 7 1946 19 S. J. LEWIS Scout

KANSAS

Kansas Pool Name MiscellaneousMap No. 17 Sec. 22 Twp. 23 R. 14EWell No. 2 FunkT. C. Craig et al. Company**COMPLETED**

Contractor

SE SW NE

SECTION PLAT

		0	

330 Ft. from N. Line330 Ft. from S. Line Ft. from E. Line830 Ft. from W. LineWoodson CountyLocation Rig up

Drilling and Remarks:

*Misc 1639**6" @ 1639**1000 acid**Pump 6 Rd**380 lb*

RECORD

Cased in., ft.Sand Gas Oil Total Depth 1650

PRODUCTION

1st 24 hrs. Nat. 1st 24 hrs. after shot Gas Cu. Ft.Dry Hole Abandoned

Date

OCT 2 1946 19

S. J. LEWIS

Scout