


KANSASSection 22 Township 23 Range 14EWell No. 1 Weiseback (*Weissback*)Company Fester & Finney

Misc.

NORTH

WEST

EAST

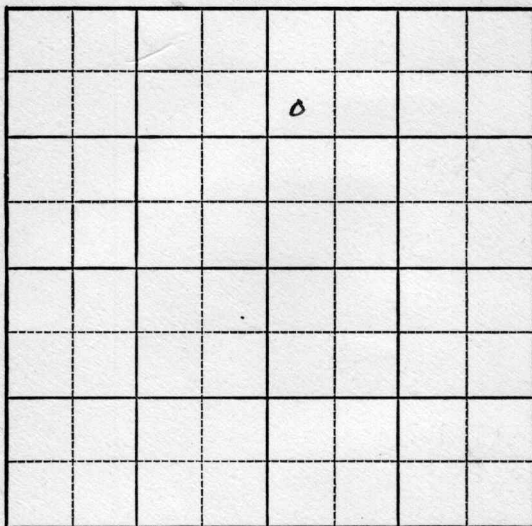

SOUTH

KANSAS Woodson

Sec. 22 Twp. 23 R. 14E

Well No. #1 Weiseback Farm

Fester & Finney Company

Miscellaneous


990' Ft. from N. Line

Ft. from S. Line

Ft. from E. Line

330' Ft. from W. Line

SW NW NE

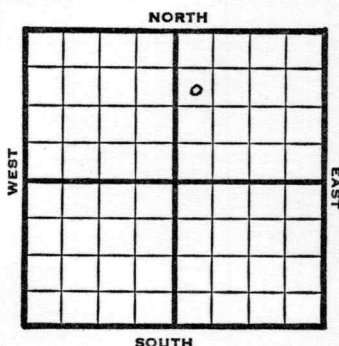

1949

REPORT

3/9 Location

3/16 "

3/23 "

3/30 Mach.

4/6 Drlg. 75'

4/12 8" @ 845'

4/20 Drlg. 1320'

4/27 "

5/4 Miss 1685'

TD 1697'

5" @ 1694'

5/10 1000 acid

5/18 TD 1697'

Miss 1685'

5" @ 1694'

1000 acid

Pump 15 oil pot

38° Gr.

Comp

COMPLETED

Map No. _____ Sec. 22 Twp. 23 R. 14EWell No. 1 WeisebackFester & Finney CompanyFIRST REPORT Contractor


SW NW NE

SECTION PLAT

990 Ft. from N. Line

_____ Ft. from S. Line

_____ Ft. from E. Line

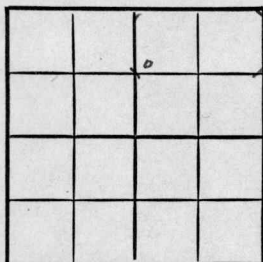330 Ft. from W. LineWoodson CountyLocation X

Rig up _____

Drilling and Remarks:

RECORD

Cased _____ in., _____ ft.

Sand _____

Gas _____

Oil _____

Total Depth _____

PRODUCTION

1st 24 hrs. Nat. _____

1st 24 hrs. after shot _____

Gas _____ Cu. Ft.

Dry Hole _____

Abandoned _____

Date

MAR 9 194919S. J. LEWISScout

Kansas

Miscellaneous

Map No. K17 Sec. 22 Twp. 23 R. 14EWell No. 1 WeisebackFester & Finney CompanyCOMPLETE Contractor

SW NW NE

SECTION PLAT

		2	

990 Ft. from N. Line Ft. from S. Line Ft. from E. Line330 Ft. from W. LineWoodson CountyLocation Rig up

Drilling and Remarks:

*Misc 1685**5" C 1694**1000000**Pump Bail 1000**1000000*

RECORD

Cased in., ft.Sand Gas Oil Total Depth 1687

PRODUCTION

1st 24 hrs. Nat. 1st 24 hrs. after shot Gas Cu. Ft.Dry Hole Abandoned

Date

MAY 18 1949

19

S. J. LEWIS Scout