


Map No. _____ Sec. 16 Twp. 27 R. 4Well No. 6-Loomis Farm _____Gilliland Company _____

NORTH

WEST

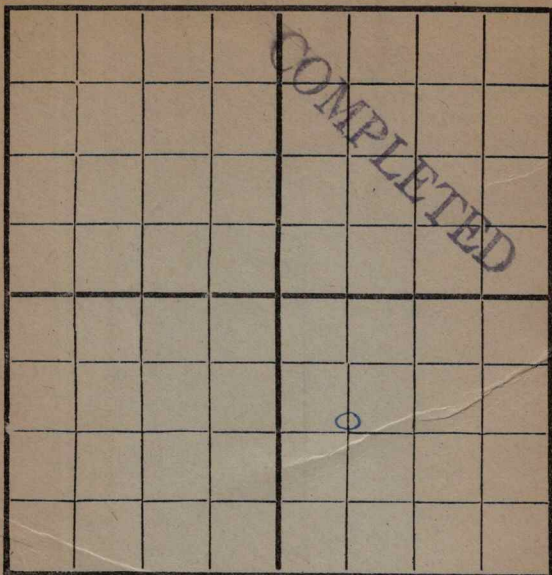

EAST

SOUTH

Location _____

Rig Up 10/10/16

Drilling Remarks:

Drilling Remarks:

10/17
10/24 - Rigging up
780 = 10/19
850 = 11/14
1500 = 11/25
1740 = 12/4
2115 = 12/11
2245 = 12/18
2460 = 12/28 - top sand

RECORD

Cased _____ in _____ Ft.
 Sand _____
 Gas _____
 Oil _____
 Total Depth _____

PRODUCTION


1st 24 hrs. Nat. _____
 1st 24 hrs. after shot _____
 Gas _____ Cu. Ft.
 Dry Hole _____
 Abandoned _____

Map No. _____ Sec. 16 Twp. 27 R. 4
Well No. 10010 Farm _____
Phillips Company

NORTH

WEST

EAST

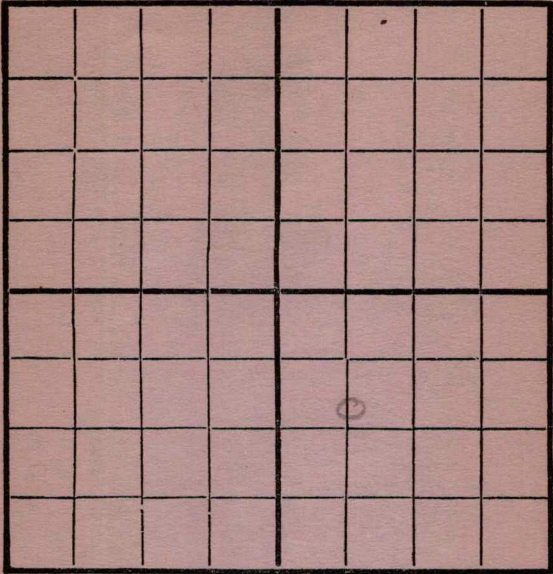

SOUTH

Location ✓
Rig Up ✓
Drilling and remarks

RECORD

Cased _____ in. _____ Ft.
Sand _____
Gas _____
Oil _____
Total Depth _____

PRODUCTION

1st 24 hrs. Nat. _____
First 24 hrs. after shot _____
Gas _____ Cu. Ft.
Dry Hole _____
Abandoned _____


Date 10/10, 1916 Lee Scout

Map No. _____ Sec. 16 Twp. 27 R. 4
 Well No. 6 Loomis Farm _____
Billings Company _____

NORTH

WEST

EAST

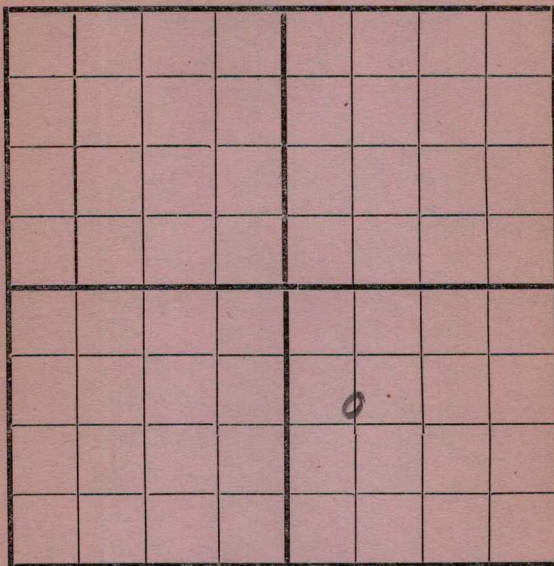

SOUTH

Location _____
 Rig Up ☒ _____
 Drilling and remarks _____

RECORD

Cased _____ in. _____ Ft.
 Sand _____
 Gas _____
 Oil _____
 Total Depth _____

PRODUCTION

1st 24 hrs. Nat. _____
 1st 24 hrs. after shot _____
 Gas _____ Cu. Ft.
 Dry Hole _____
 Abandoned _____

Date


10/17, 1916 L. L. Loomis Scout

Map No. _____ Sec. 16 Twp. 27 R. 4
 Well No. 6 Farm _____
Gilbert Company _____

NORTH

WEST

EAST

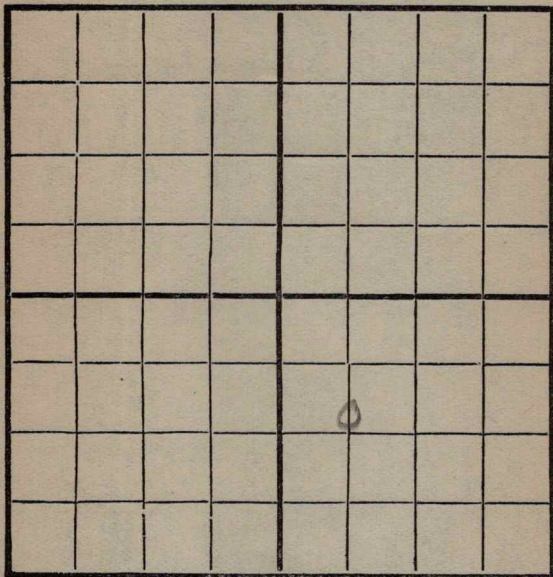

SOUTH

Location _____
 Rig Up _____
 Drilling and remarks _____

Rigging

RECORD

Cased _____ in. _____ Ft.
 Sand _____
 Gas _____
 Oil _____
 Total Depth _____

PRODUCTION


1st 24 hrs. Nat. _____
 First 24 h.s. after shot _____
 Gas _____ Cu. Ft.
 Dry Hole _____
 Abandoned _____

Date 10/24 1916 Cliff Scout

Map No. _____ Sec. 16 Twp. 27 R. 4

Well No. 6 Loomis Farm

Gilliland Company

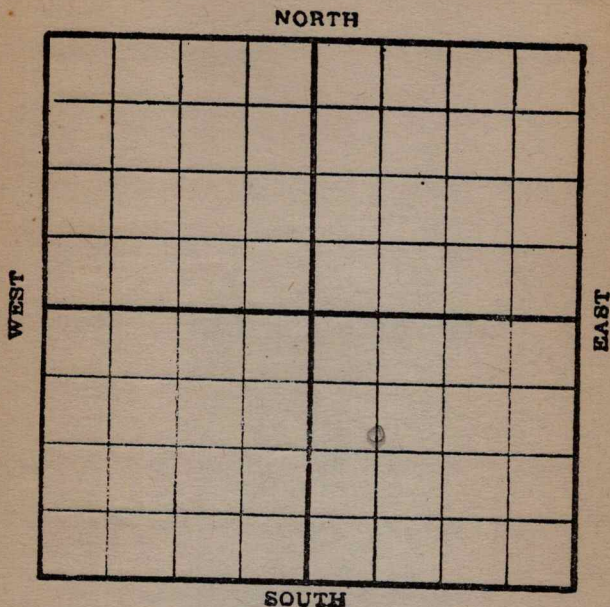

Location _____

Rig up _____

Drilling and remarks:

350

RECORD

Cased _____ in. _____ Ft.

Sand _____

Gas _____

Oil _____

Total Depth _____

PRODUCTION

1st. 24 hrs. Nat. _____

1st. 24 hrs. after shot _____

Gas _____ Cu. Ft.

Dry Hole _____

Abandoned _____


Date

10/30, 1916, Ree

Scout

Map No. _____ Sec. 16 Twp. 27 R. 4
 Well No. 6000 Farm _____
Gilliland Company

NORTH

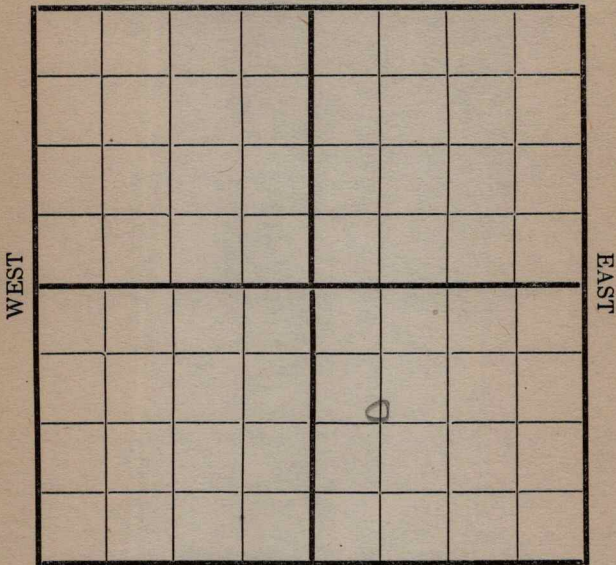

SOUTH

Location _____
 Rig Up _____
 Drilling and remarks

780

RECORD

Cased _____ in. _____ Ft.
 Sand _____
 Gas _____
 Oil _____
 Total Depth _____

PRODUCTION


1st 24 hrs. Nat. _____
 1st 24 hrs. after shot _____
 Gas _____ Cu. Ft.
 Dry Hole _____
 Abandoned _____

Date 11/9, 1916 W. C. Anderson Scout

Map No. _____ Sec. 16 Twp. 22 R. 4
 Well No. 6 _____ Farm _____
Fuller _____ Company _____

NORTH

WEST

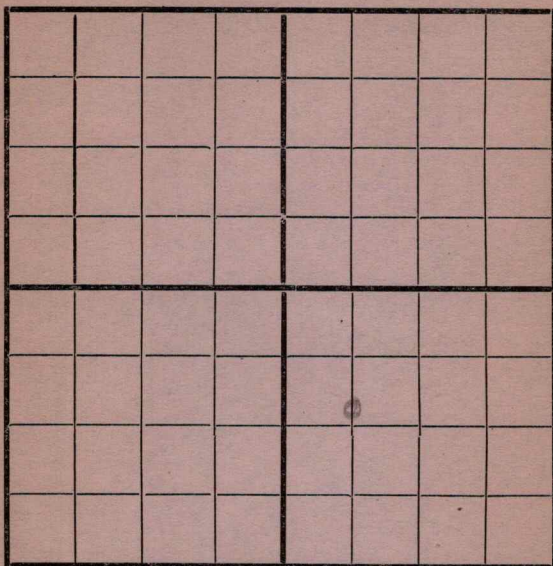

EAST

SOUTH

Location _____

Rig Up _____

Drilling and remarks

850

RECORD

Cased _____ in. _____ Ft.

Sand _____

Gas _____

Oil _____

Total Depth _____

PRODUCTION

1st 24 hrs. Nat. _____

1st 24 hrs. after shot _____

Gas _____ Cu. Ft.

Dry Hole _____


Abandoned _____

Date

1/14/16 _____ Scout

Map No. _____ Sec. 16 Twp. 27 R. 4
 Well No. 6 Loomis Farm _____
Billings Company _____

NORTH

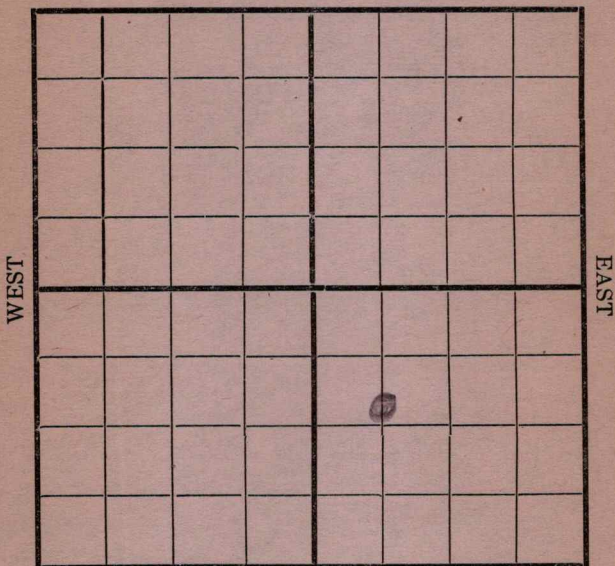

SOUTH

Location _____

Rig Up _____

Drilling and remarks

RECORD

Cased _____ in. _____ Ft.

Sand _____

Gas _____

Oil _____

Total Depth _____

PRODUCTION

1st 24 hrs. Nat. _____

1st 24 hrs. after shot _____

Gas _____ Cu. Ft.

Dry Hole _____

Abandoned _____

Date


11/20/6 191 6 Landry Scout

Map No. 6 Sec. 16 Twp. 27 R. 4
 Well No. 6 Farm Scout
Gull Camp Company

NORTH

WEST

EAST

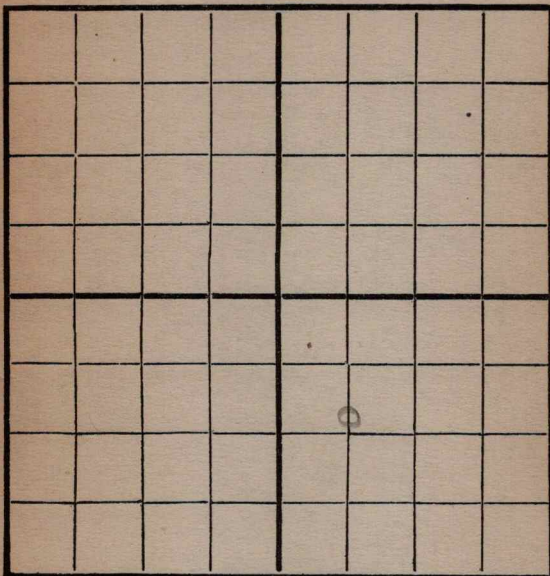

SOUTH

Location -----
 Rig Up -----
 Drilling and remarks -----

*Shut Down
 1500'*

RECORD

Cased ----- in. ----- Ft.
 Sand -----
 Gas -----
 Oil -----
 Total Depth -----

PRODUCTION

1st 24 hrs. Nat. -----
 1st 24 hrs. after shot -----
 Gas ----- Cu. Ft.
 Dry Hole -----
 Abandoned -----

Date

11/27 191 6 Scout

Map No. _____ Sec. 16 Twp. 27 R. 4Well No. 620015 Farm _____Gulliland Company _____

NORTH

WEST

EAST

SOUTH

Location _____

Rig Up _____

Drilling and remarks

1740'

RECORD

Cased _____ in. _____ Ft.

Sand _____

Gas _____

Oil _____

Total Depth _____

PRODUCTION

1st 24 hrs. Nat. _____

1st 24 hrs. after shot _____

Gas _____ Cu. Ft.

Dry Hole _____

Abandoned _____

Date


12/4/1916, 1916, Cordiff Scout _____

Map No. _____ Sec. 16 Twp. 27 R. 4Well No. 6 Loomis FarmGilliland Company

NORTH

WEST

EAST

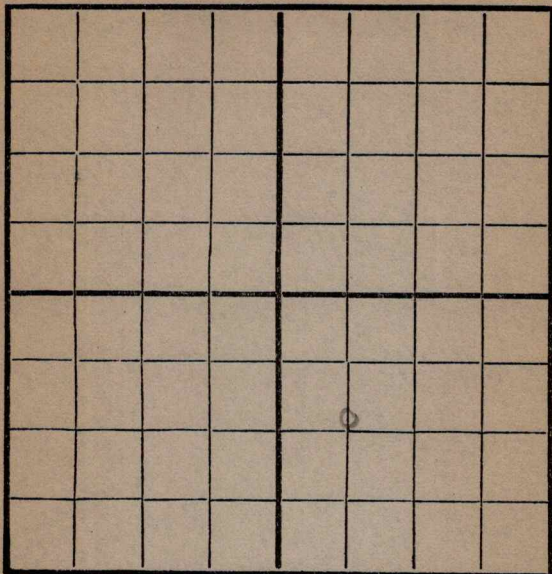

SOUTH

Location _____

Rig Up _____

Drilling and remarks

2115'

RECORD

Cased _____ in. _____ Ft.

Sand _____

Gas _____

Oil _____

Total Depth _____

PRODUCTION

1st 24 hrs. Nat. _____

1st 24 hrs. after shot _____

Gas _____ Cu. Ft.

Dry Hole _____

Abandoned _____

Date


12/11, 1916, Candiff Scout

Map No. _____ Sec. 16 Twp. 27 R. 4
 Well No. 6 Loomis Farm _____
Billings Company _____

NORTH

WEST

EAST

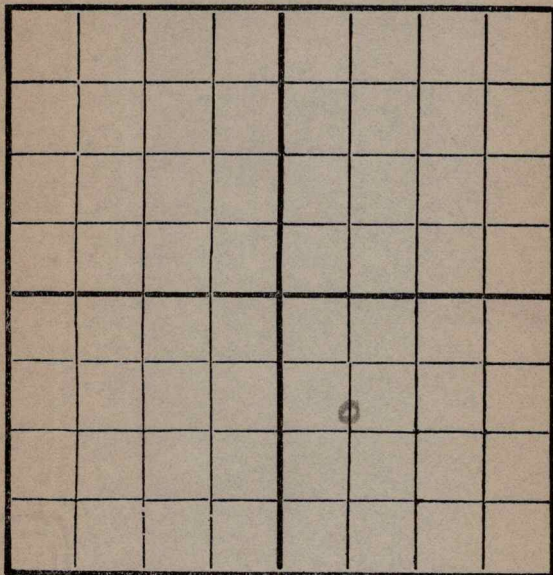

SOUTH

RECORD

Location _____

Cased _____ in. _____ Ft.

Rig Up _____

Sand _____

Drilling and remarks

Gas _____

Oil _____

Total Depth _____

2245'

PRODUCTION

1st 24 hrs. Nat. _____

1st 24 hrs. after shot _____

Gas _____ Cu. Ft.

Dry Hole _____

Abandoned _____


Date

12/18, 1916 C. Conley Scout

Map No. _____ Sec. 16 Twp. 27 R. 4

Well No. 6 Farm _____

Billings Company _____

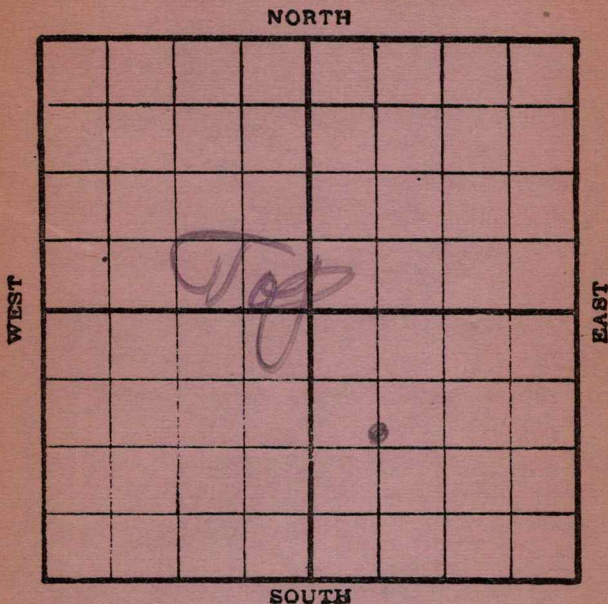

Location _____

Rig up _____

Drilling and remarks:

*Shut Down
Top sand
no showing*

RECORD

Cased _____ in. _____ Ft.

Sand 2460

Gas _____

Oil _____

Total Depth _____

PRODUCTION

1st. 24 hrs. Nat. _____

1st. 24 hrs. after shot _____

Gas _____ Cu. Ft.

Dry Hole _____

Abandoned _____

Date

Nov 6, 1916, Conley Scout