
Greenwood KANSAS

SECTION 5 TOWNSHIP 24 RANGE 11E

WELL NO. #1 South

COMPANY Eureka Drlg.

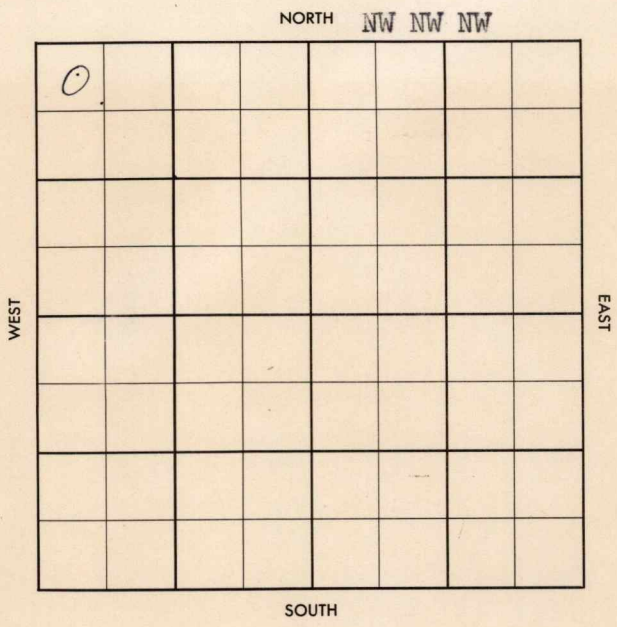

FORM 504-3 SUNRAY

FORM 513 SUNRAY

County Greenwood Elev.

Sec. 5 Twp. 24 Rge. 11E

Company Eureka Drlg.

FarmName South No. 1


TOPS	DEPTH	LOG	DATUM
Anh.			
Tp.			
H.			
Tr.			
Dg.			
Bl.			
L.			
K.C.			
B.K.C.			
Ce.			
C.			
M.			
M.			
K.			
Mz.			
Mo.			
V.			
S.			
S.			
A			
R.			
P€.			
G.			
T.D.			

Loc. in Sec. NW NW NW

Geol.

Contr. Co. tools

Pool Gaffney Ext.

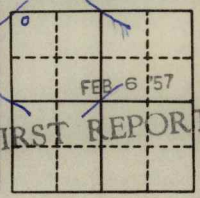

Date Comm.

spdg.

Co. Lse. No. Sec. T. R.

FORM 513 SUNRAY

County Greenwood Elev.

Sec. 5 Twp. 24 Rge. 11E

Company Eureka Drlg.

Farm Name South No. 1

TOPS	DEPTH	LOG	DATUM
Anh.			
Tp.			
H.			
Tr.			
Dg.			
B.L.			
L.		1010	
K.C.		1300	
B.K.C.		1471	
Ce.			
C. clev sd		1481	
M. Lenepah		1589	
M. Altam Ls		1613	
K. Pawnee Ls		1680	
Mz. Ft Scr Ls		1708	
Mc. ce sh		1749	
V. Sqyr sd		1794	
S. Ardm. Ls		1839	
S. Cattl. sd.		1854	
A Bart. sd		1886	
R. Bartl sd		1988-2002	
P€.			
G.			
T.D.	2040	2042	

Loc. in Sec. NW NW NW

Geol.

Contr. Co. tools

Pool Gaffney Ext.

ABANDONED FEB 27 '57

Date Comm.

spdg. FEB 13 '57 ✓ FEB 20 '57 D 713

cmp 2-27-57 cmd 1555-80

D & A

Co. Lse. No. Sec. T. R.