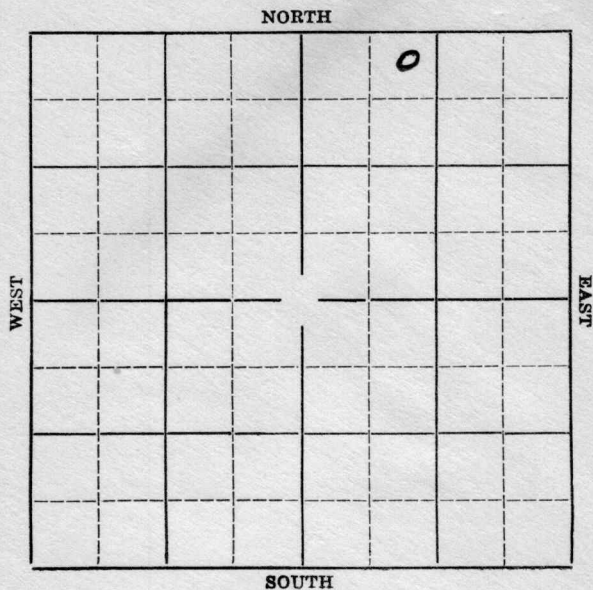
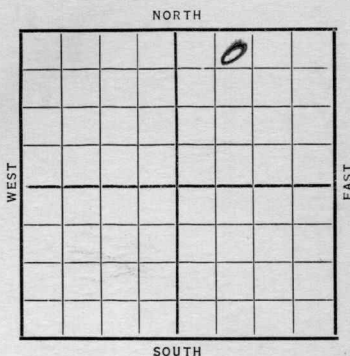


Section 23 Township 23 Range 14-EWell Number #1-VostardCompany McClintock et al

Sec. 23 Twp. 23 R. 14EWell No. #1 Vostard FarmMcClintock et al

Company

330' Ft. from N. Line Ft. from S. Line Ft. from E. Line990' Ft. from W. LineDate 1936

REPORT

8/29

Miss. Lime. 1587'.

Pay 1607-28'.

T.D. 1628'.

3000 gallons of acid.

150 bbls of oil.

FIRST REPORTS

— and —

COMPLETED.

p No. 17 Sec. 23 Twp. 23 R. 14⁷Well No. 1 VostardM^c Clintock & Dal Company

Contractor

SECTION PLAT

		0	

330 Ft. from N. Line

_____ Ft. from S. Line

_____ Ft. from E. Line

990 Ft. from W. Line

COMPLETED

Location _____

Rig up _____

Drilling and Remarks:

Miss L. 1587
Pay 1607-28
3000 acid
150 8 1/2

RECORD

Cased _____ in., _____ ft.

Sand _____

Gas _____

Oil _____

Total Depth 1628

PRODUCTION

1st 24 hrs. Nat. _____

1st 24 hrs. after shot _____

Gas _____ Cu. Ft.

Dry Hole _____

Abandoned _____

Date

AUG 19 1936

19

S. J. LEWIS


Scout

KANSAS

Map No. _____ Sec. 23 Twp. 23 R. 14EWell No. 1 VostardMcClintock & Co. Company

Contractor

SECTION PLAT

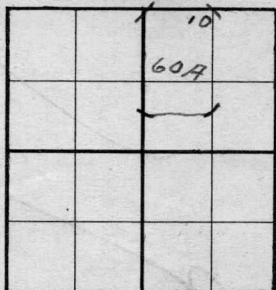330 Ft. from N. Line

_____ Ft. from S. Line

_____ Ft. from E. Line

990 Ft. from W. Line

Location _____

Rig up _____

Drilling and Remarks:

RECORD

Cased _____ in., _____ ft.

Sand _____

Gas _____

Oil _____

Total Depth _____

PRODUCTION

1st 24 hrs. Nat. _____

1st 24 hrs. after shot _____

Gas _____ Cu. Ft.

Dry Hole _____

Abandoned _____

Date

8/27 1936

S. J. LEWIS Scout