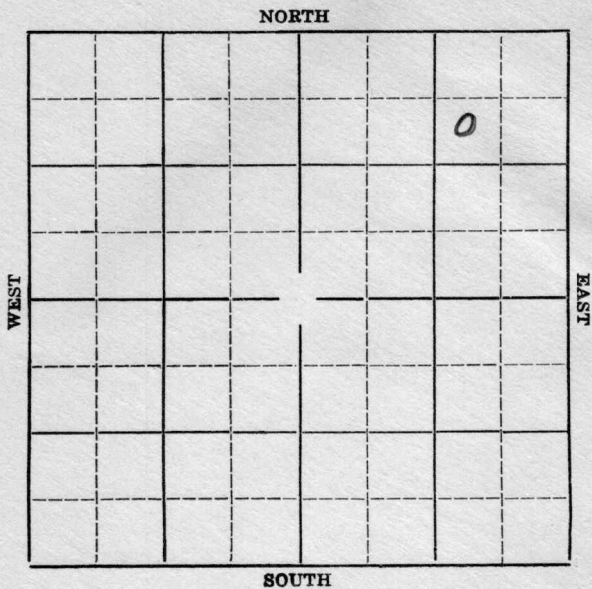


Section 23 Township 23 Range 14-EWell Number 2-VostardCompany Henderson

Map No. KANSAS Sec. 23 Twp. 23 R. 14E

Well No. #2 Vostard Farm


Henderson Company

990' Ft. from N. Line

Ft. from S. Line

990' Ft. from E. Line

Ft. from W. Line

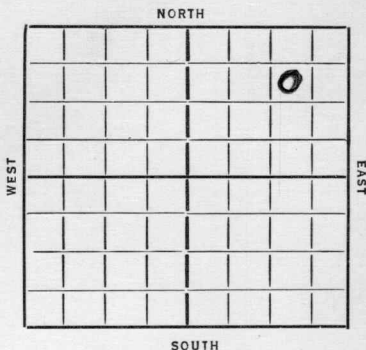

Date
1936

REPORT

6/24 Machine. Spud.

7/2 Drlg. 900'.

7/9 Drlg 1610'.

7/15/36-Miss. Lime 1595'.

T.D. 1635'.

1000 gallons of acid.

20 bbls of oil potential.

COMPLETED

KANSAS

Map No. 17 Sec. 23 Twp. 23 R. 14EWell No. 2 VostardHenderson Company

Contractor

SECTION PLAT

			0

990 Ft. from N. Line

Ft. from S. Line

990 Ft. from E. Line

Ft. from W. Line

FIRST REPORT

Location _____

Rig up _____

Drilling and Remarks:

Wach
Spud

RECORD

Cased _____ in., _____ ft.

Sand _____

Gas _____

Oil _____

Total Depth _____

PRODUCTION

1st 24 hrs. Nat. _____

1st 24 hrs. after shot _____

Gas _____ Cu. Ft.

Dry Hole _____

Abandoned _____

Date

JUN 24 1936

19

S. J. LEWIS

Scout

KANSAS

Map No. 17 Sec. 23 Twp. 23 R. 14EWell No. 2 VistardHenderson

Company

Contractor

SECTION PLAT

			0

990 Ft. from N. Line

_____ Ft. from S. Line

990 Ft. from E. Line

_____ Ft. from W. Line

COMPLETED

Location _____

Rig up _____

Drilling and Remarks:

Miss L. 1595
1000 acid
20 8 1/2.

RECORD

Cased _____ in., _____ ft.

Sand _____

Gas _____

Oil _____

Total Depth 1635

PRODUCTION

1st 24 hrs. Nat. _____

1st 24 hrs. after shot _____

Gas _____ Cu. Ft.

Dry Hole _____

Abandoned _____

Date

JUL 15 1936

19

S. J. LEWIS Scout