
DX 78-1 Greenwood

KANSAS

Section 6 Township 24 Range 11E

Well No. #11 Kipfer

Company Ward McGinnis

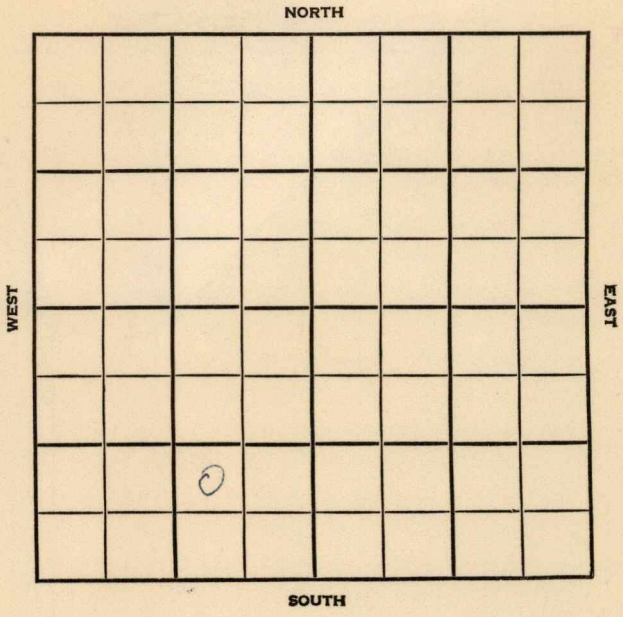

Greenwood KANSAS

SEC.	TWP.	R.
6	24	11E

WELL NO.

#11 Kipfer FARM

COMPANY

Ward McGinnis

CONTRACTOR

Co. Tools

Wiggins


_____ FT. FROM N. LINE

750' FT. FROM S. LINE

900 FT. FROM E. LINE

_____ FT. FROM W. LINE

NW SE SW

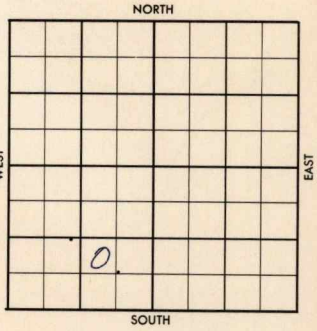

1956	ELEVATION REPORT
8-22	Comm. 8-11-56 8" @ 105 5" @ 2000 w/150 Cattleman 1834'; Bart. 1907';Miss.2132 TD 2140'

FORM 504-5 SUNRAY

FORM 513 SUNRAY

County Greenwood Elev.

Sec. 6 Twp. 24 Rge. 11E

Company Ward McGinnis

Farm Name Kipfer No. 11

TOPS	DEPTH	LOG	DATUM
Anh.			
Tp.			
H.			
Tr.			
Dg.			
B.L.			
L.			
K.C.			
B.K.C.			
Ce.			
C. Cattleman	1834		
M.			
M.			
K. Bart.	1907		
Mz.			
Mo. Miss.	2132		
V.			
S.			
S.			
A			
R.			
Pe.			
G.			
T.D.	2140		

Loc. in Sec. NW SE SW

750' SL

900' EL

Geol.

Contr. Co. tools

Pool Wiggins

COMPLETE

Date Comm. 8-11-56 OCT 10 1956

8" @ 105 5" @ 2000/150 AUG 29 '56 102/

1907-35 32/1836-44 Plg

@ 1865 tst wtr. SEP 5 '56 SEP 12 '56

SEP 19 '56 ✓ SEP 26 '56 OCT 3 '56 ✓ OCT 10 '56 SQ &

Cattleman sd oil wells

Tite P. est 25 Bopd.

Co. Lse. No. Sec. T. R.

FORM 513 SUNRAY

County Greenwood Elev.

Sec. 6 Twp. 24 Rge. 11E

Company Ward McGinnis

Farm Name Kipfer No. 11

TOPS	DEPTH	LOG	DATUM
Anh.			
T.P.			
H.			
Tr.			
Dg.			
B.L.			
L.			
K.C.			
B.K.C.			
C. Cattleman	1834		
M.			
M. K. Bart.	1907		
Mz. Mo. Miss.	2132		
V.			
S.			
S.			
A			
R.			
P€.			
G.			
T.D.	2140		

Loc. in Sec. NW SE SW

750' SL

900' EL

Geol.

Contr. Co. tools

Pool Wiggins

FIRST REPORT

AUG 22 '56

Date Comm. 8-11-56

8" @ 105 5" @2000/150

Co. Lse. No. Sec. T. R.