
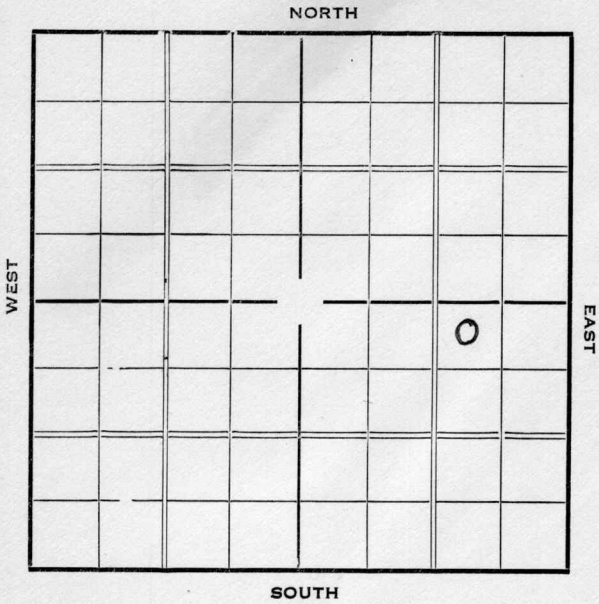


Section 23 Township 23 Range 14-E

Well Number 4 Vostrez

Company Henderson Oil

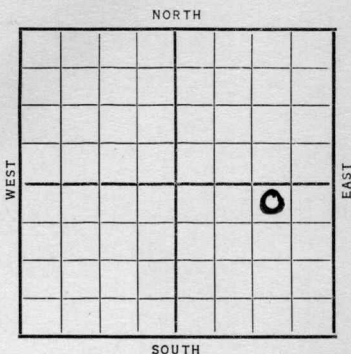

Sec. 23 Twp. 23 R. 14-EWell No. #4 Vostrez FarmHenderson Oil Company330 Ft. from N. Line Ft. from S. Line990 Ft. from E. Line Ft. from W. Line

Date

REPORT

1937**6/23**

Chat 1611'. Miss. 1614'.

T.D. 1618'. 2 bbls. P.H.

Nat. 1000 acid.

6/30

Miss. 1614'.

T.D. 1618'.

Pot. 30 bbls.

COMPLETED

Woodson KANSAS

Map No. 17 Sec. 23 Twp. 23 R. 14^EWell No. 4- VostrezHenderson Oil Company

Contractor

FIRST REPORT

SECTION PLAT

			0

330 Ft. from N. Line

_____ Ft. from S. Line

990 Ft. from E. Line

_____ Ft. from W. Line

Location _____

Rig up _____

RECORD

Cased _____ in., _____ ft.

Sand _____

Gas _____

Oil _____

Total Depth _____

PRODUCTION

1st 24 hrs. Nat. _____

1st 24 hrs. after shot _____

Gas _____ Cu. Ft.

Dry Hole _____

Abandoned _____

Drilling and Remarks:

CHAT 1611

MISS 1614

T.D. 1618

2 bbls P.H. nat

1000 Acid

Date

JUN 23 1937

19

H. D. Hatfield Scout

KANSAS

Woodson

Map No. 17 Sec. 23 Twp. 23 R. 14 ^EWell No. 4 - VostreyHenderson Oil Company

Contractor

COMPLETED

SECTION PLAT

			o

330 Ft. from N. Line

_____ Ft. from S. Line

990 Ft. from E. Line

_____ Ft. from W. Line

Location _____

Rig up _____

Drilling and Remarks:

Pot-30

RECORD

Cased _____ in., _____ ft.

Sand MISS 1614

Gas _____

Oil _____

Total Depth 1618

PRODUCTION

1st 24 hrs. Nat. _____

1st 24 hrs. after shot _____

Gas _____ Cu. Ft.

Dry Hole _____

Abandoned _____

Date

H. D. Hatfield

JUN 30 1937 19 _____ Scout