


O.W.W.O.

Map No. **KANSAS** Sec. 16 Twp. 24 R. 11
 Well No. 1 Free man Farm
Marcus et al Company
 NORTH Hard Mc Innis

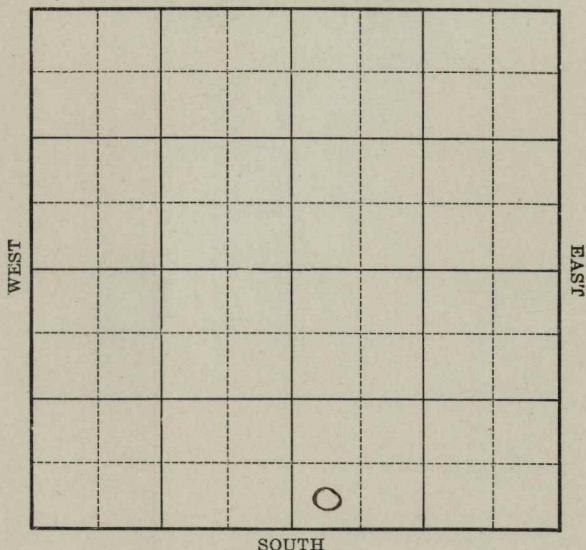

Location _____

Drilling Remarks _____

Rig Up _____

Drilling Remarks _____

RECORD

Cased _____ in. _____ ft.

Sand _____

Gas _____

Oil _____

Total Depth _____

PRODUCTION

1st 24 hrs. Nat. _____

1st 24 hrs. after shot _____

Gas _____ cu. ft.

Dry Hole _____

Abandoned _____

16 KANSAS

Sherwood

E

Map No. _____ Sec. 6 Twp. 24 R. 11

Well No. 1 Freeman or CLIFFER

Marcus et al KGS/DML Company

Contractor

SECTION PLAT

FIRST REPORTS

_____ Ft. from N. Line

330 _____ Ft. from S. Line

_____ Ft. from E. Line

330 _____ Ft. from W. Line

Location _____

Rig up _____

Drilling and Remarks:

Rigging up

RECORD

Cased _____ in., _____ ft.

Sand _____

Gas _____

Oil _____

Total Depth _____

PRODUCTION

1st 24 hrs. Nat. _____

1st 24 hrs. after shot _____

Gas _____ Cu. Ft.

Dry Hole _____

Abandoned _____

Date

APR 12 1928

CHAS. L. SHERWOOD

192

Scout

Gmwood

16 **KANSAS** SEC. 6 TWP. 74 R. 11
 MAP NO. _____
 WELL No. 1 Freeman or KIPFER
 Marcus et al IKGSDML COMPANY

CONTRACTOR

SECTION PLAT

COMPLETED

_____ FT. FROM N. LINE
 330 _____ FT. FROM S. LINE
 _____ FT. FROM E. LINE
 330 _____ FT. FROM W. LINE

		0	

LOCATION _____

RIG UP _____

DRILLING AND REMARKS:

60/20 Bbs.

RECORD

CASED _____ IN. _____ FT.
 SAND 1846-1860
 GAS _____
 OIL _____
 TOTAL DEPTH 1871

PRODUCTION

1ST 24 HRS. NAT. _____
 1ST 24 HRS. AFTER SHOT _____
 GAS _____ CU. FT.
 DRY HOLE _____
 ABANDONED _____

DATE

MAY 10 1928

CHAS. L. SHERWOOD

192

SCOUT

O.W.W.O.

FORM 513 SUNRAY

County Greenwood Elev. _____
 Sec. 6 Twp. 24 Rge. 11E
 Company Ward McGinnis
 Farm Name Kipfer No. 12

Co.

Lse.

No.

Sec.

T.

R.

TOPS DEPTH LOG DATUM

Anh. _____
 Tp. _____
 H. _____
 Tr. _____
 Dg. _____
 B.L. _____
 L. _____
 K.C. _____
 B.K.C. _____
 Ce. _____
 C. _____
 M. _____
 M. _____
 K. _____
 Mz. _____
 Mq. _____
 V. _____
 S. _____
 S. _____
 A. _____
 R. _____
 P.E. _____
 G. _____
 T.D. _____

Loc. in Sec. SW SW SE

O.W.W.O

Geol. _____

Contr. _____

Co. Tools

Pool

Gaffney

FIRST REPORT

NOV 7 56

0

Date Comm.

Old Inf. was old producer sq. sq. OTD 1871

New Inf. MIRT dd 1982 RTD in Cattleman Sd,

4" @ 1982 w/100, WOC

[Handwritten signature]

County Greenwood Elev. _____

Sec. 6 Twp. 24 Rge. 11E

Company Ward McGinnis

Farm Name Kipfer No. 12

TOPS	DEPTH	LOG	DATUM	Loc. in Sec.
Anh.				SW SW SE
Tp.				
H.				O.W.W.O
Tr.				
Dg.				
Bl. <u>56 sd 1846-63</u>				
L. <u>CDH/esd 1935-50</u>				
K.C.				Geol.
B.K.C.				Contr.
Ce.				Co. Tools
C.				
M.				Pool
M.				Gaffney
K.				
Mz.				
Me.				
V.				
S.				
S.				
A.				
R.				
Pe.				
G.				
T.D.				

COMPLETE
NOV 23 '56

Date Comm.

Old Inf. was old producer sq. sq. OTD 1871

New Inf. MIRT dd 1982 RTD in Cattlemen Sd.

L" @ 1982 w/100, WOC NOV 13 '56 NOV 21 '56

CO 20/1935-45 & 3 B0 + 2/10

BW 1 hr P. 30 B0 pd + 10% wth