

Greenwood

KANSAS

6

24


11E

SECTION _____ TOWNSHIP _____ RANGE _____

WELL NO. #18 Kipfer

COMPANY Ward McGinnis

NORTH

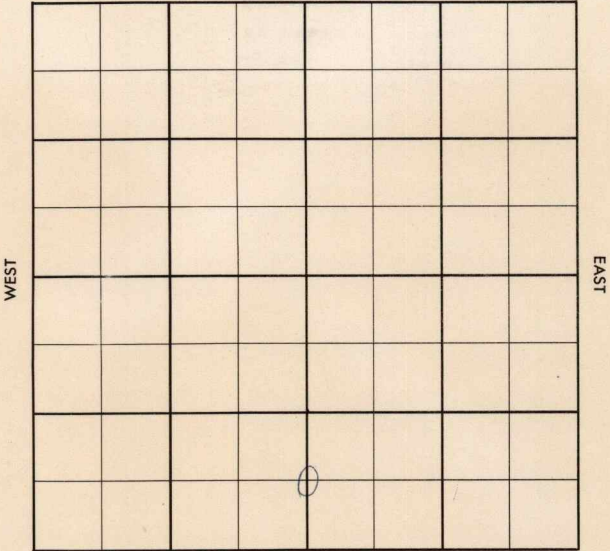

SOUTH

County Greenwood Elev. 1202 ft.
 Sec. 6 Twp. 21 Rge. 11E
 Company Ward & Ginniss
 Farm Name Kiefer No. 18

TOPS	DEPTH	LOG	DATUM	Loc. in Sec.
Anh.				C S ¹ S ¹
Tp.				
H.				
Tr.				
Dg.				
Bl.				
L. <u>castlesd</u>	<u>1912-22</u>			Geol.
K.C. <u>" "</u>	<u>1926-40</u>			Contr.
B.K.C.				Co. tools
Ce.				Pool
C.				<u>Gaffney</u>
M.				
M.				
K.				
Mz.				
Mo.				
V.				
S.				
S.				
A.				
R.				
Pe.				
G.				
T.D.	<u>1980?</u>			

COMPLETE

FEB 20 '57

Date Comm.

Pipe set JAN 23 '57 ✓ JAN 30 '57

10" @ 60 9 1/2 @ 1980 Co 1951

GRNL 40 / 1912-22 FEB 6 '57 ✓

FEB 13 '57 FEB 20 '57 Frac est P.

25 Bopd + 10% wtr

County Greenwood Elev. _____
 Sec. 6 Twp. 24 Rge. 11E
 Company Ward McGinnis
 Farm Name Kipfer No. 18

TOPS	DEPTH	LOG	DATUM	Loc. in Sec.
Anh.				C S $\frac{1}{2}$ S $\frac{1}{2}$
Tp.				
H.				
Tr.				
Dg.				
Bl.				
L.				Geol. _____
K.C.				Contr. _____
B.K.C.				Co. tools _____
Ce.				Pool _____
C.				Gaffney
M.				FIRST REPORT JAN 16 1957
M.				
K.				
Mz.				
Mq.				
V.				
S.				
S.				
A.				
R.				
PE.				
G.				
T.D.				

Date Comm.

Pipe set

80