

Section 10 Township 24 Range 11-E

Well No. #1 Short

Company A. D. Allison

Wildcat

NORTH

WEST

EAST

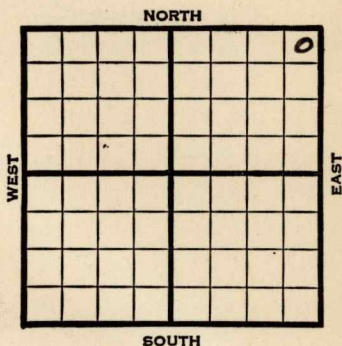
							0

SOUTH

KANSAS

Sec. 10 Twp. 24 R. 11EWell No. 1-Short FarmA. D. Allison Company

(Wildcat)

330 Ft. from N. Line Ft. from S. Line330 Ft. from E. Line Ft. from W. Line

1940

REPORT

8/28

Mach

9/5

Drlg. 580'

9/12

10" - 800' Drlg. 1150'

9/18

Miss. 1927'

T.D. 1956'

No shows.

ABANDONED

Map No. 16 Sec. 10 Twp. 24 R. 11EWell No. 1 Short

A. D. Allison

Company

Contractor

FIRST REPORT

NE/C

330 Ft. from N. Line Ft. from S. Line330 Ft. from E. Line Ft. from W. Line

SECTION PLAT

			0

WILDCAT

Location Rig up

Drilling and Remarks:

Mach

RECORD

Cased in., ft.Sand Gas Oil Total Depth

PRODUCTION

1st 24 hrs. Nat. 1st 24 hrs. after shot Gas Cu. Ft.Dry Hole Abandoned

Date

AUG 28 1940

19

S. J. LEWIS Scout

Map No. 16 Sec. 10 Twp. 24 R. 11EWell No. 1 ShortA..D. Allison

Company

Contractor

ABANDONED

NE/C

330 Ft. from N. Line

Ft. from S. Line

330 Ft. from E. Line

Ft. from W. Line

SECTION PLAT

			0

WILDCAT

Location _____

Rig up _____

Drilling and Remarks:

*Miss 1927**No shows*

RECORD

Cased _____ in., _____ ft.

Sand _____

Gas _____

Oil _____

Total Depth 1956

PRODUCTION

1st 24 hrs. Nat. _____

1st 24 hrs. after shot _____

Gas _____ Cu. Ft.

Dry Hole _____

Abandoned _____

Date

SEP 18 1940 19S. J. LEWIS Scout