


Map No. KANSAS Sec. 13 Twp. 23 R. 14^E
 Well No. 1- Scott Farm
Prairie Oil Co. Company

NORTH

WEST

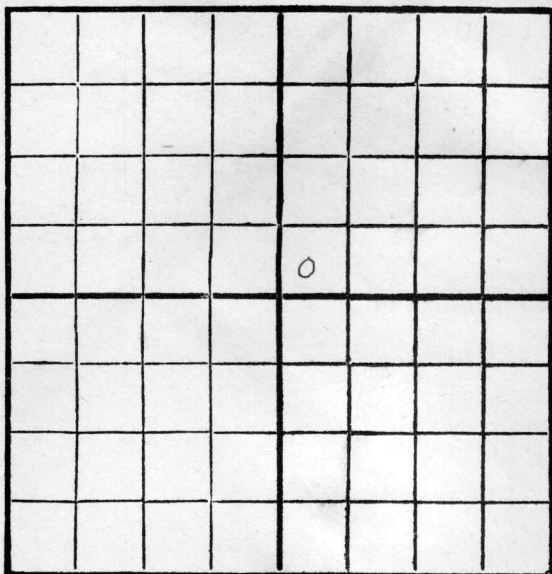

EAST

SOUTH

Location _____

Drilling Remarks _____

RECORD

Cased _____ in. _____ ft.
 Sand _____
 Gas _____
 Oil _____
 Total Depth _____

Rig Up _____

Drilling Remarks _____

PRODUCTION

1st 24 hrs. Nat. _____
 1st 24 hrs. after shot _____
 Gas _____ cu. ft.
 Dry Hole _____
 Abandoned _____

Map No. KANSAS Sec. 13 Twp. 23 R. 14^E

Well No. 1-Scott Farm


Prairie Oil Company

_____ Ft. from N. Line

200 Ft. from S. Line

_____ Ft. from E. Line

200 Ft. from W. Line

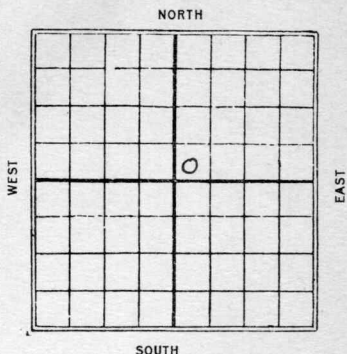

1929

Date	REPORT
10/30	Regg up
11/6	Spdy.
11/13	Wrlg 500'
11/20	" 700'
11/27	" 775'
12/4	" 1200'
12/11	" 1530'
12/23	Top line 1602'
	SD 1616'
12/30	Top line 1602'
	show 1630-34'
	FD. 1652'
	Dry & Abandoned

17 KANSAS

Map No. _____ Sec. 13 Twp. 73 R. 14^E

Well No. 1 Scott

Prairie Dist Gas Co. Company

Contractor

FIRST REPORTS

_____ Ft. from N. Line

700 Ft. from S. Line

_____ Ft. from E. Line

700 Ft. from W. Line

SECTION PLAT

		0	

Location _____

Rig up _____

Drilling and Remarks: _____

RECORD

Cased _____ in., _____ ft.

Sand _____

Gas _____

Oil _____

Total Depth _____

PRODUCTION

1st 24 hrs. Nat. _____

1st 24 hrs. after shot _____

Gas _____ Cu. Ft.

Dry Hole _____

Abandoned _____

Date

OCT 30 1929

192

CHAS. L. SHERWOOD

Scout

Map No. **17** **KANSAS** Sec. **13** Twp. **23** R. **14^E**

Well No. **1** **Scott**

Prairie Oil & Gas Company

Contractor

COMPLETE

Ft. from N. Line

700 Ft. from S. Line

Ft. from E. Line

700 Ft. from W. Line

ABANDONED

SECTION PLAT

		0	

Location

Rig up

Drilling and Remarks:

Tap line 1602
Shew 1630-1634

RECORD

Cased **13** in., **1652** ft.

Sand

Gas

Oil

Total Depth **1652**

PRODUCTION

1st 24 hrs. Nat.

1st 24 hrs. after shot

Gas **✓** Cu. Ft.

Dry Hole **✓**

Abandoned **✓**

Date

DEC 30 1929

192

CHAS. L. SHERWOOD

Scout