


Map No. KANSAS Sec. 13 Twp. 23 ~~24~~ R. 14<sup>E</sup>  
 Well No. 1 - Scott Farm  
Ellis & Huff Company

NORTH

WEST

EAST

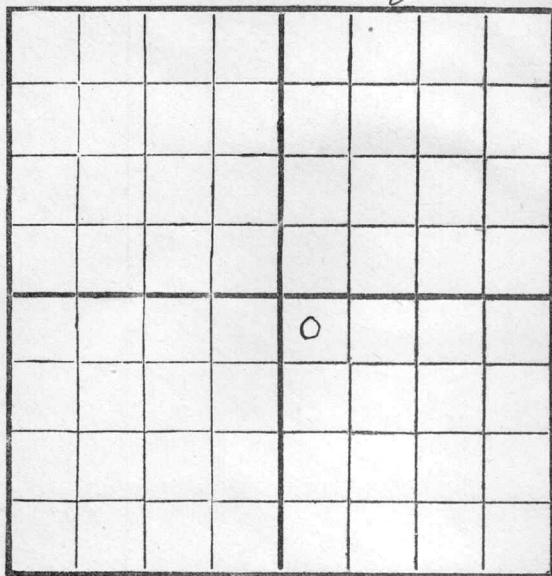

SOUTH

Location \_\_\_\_\_

Drilling Remarks \_\_\_\_\_

Rig Up \_\_\_\_\_

Drilling Remarks \_\_\_\_\_

### RECORD

Cased \_\_\_\_\_ in. \_\_\_\_\_ ft.

Sand \_\_\_\_\_

Gas \_\_\_\_\_

Oil \_\_\_\_\_

Total Depth \_\_\_\_\_

### PRODUCTION

1st 24 hrs. Nat. \_\_\_\_\_

1st 24 hrs. after shot \_\_\_\_\_

Gas \_\_\_\_\_ cu. ft. \_\_\_\_\_

Dry Hole \_\_\_\_\_

Abandoned \_\_\_\_\_


*Coffey Woodson* ~~24~~  
 Map No. KANSAS Sec. 13 Twp. 23 R. 14<sup>E</sup>  
 Well No. 1-Scott Farm  
Ellis & Huff Company

250 Ft. from N. Line

\_\_\_\_\_ Ft. from S. Line

\_\_\_\_\_ Ft. from E. Line

250 Ft. from W. Line

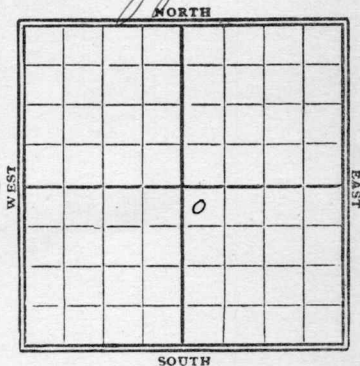

1929

Date

REPORT

8/7 Machine  
 8/14 Spdy.  
 8/21  
 8/28 Spdy & S.D.  
 9/4 Drlg 550'  
 9/11 S.D. 550'  
 9/18 show oil 1219-35'  
 drlg 1300'  
 9/25 Top line 1590'  
 sand 1612-23'  
 T.D. 1623'  
 shot 60 at  
 30 bbl oil  
 Somp.

Map No. KANSAS Sec. 13 Twp. 73 R. 14<sup>E</sup>

Well No. 1 Scatt

Ellis & Huff Company

Contractor

## FIRST REPORTS

750 Ft. from N. Line

..... Ft. from S. Line

..... Ft. from E. Line

750 Ft. from W. Line

## SECTION PLAT

|  |  |   |  |
|--|--|---|--|
|  |  |   |  |
|  |  |   |  |
|  |  | 0 |  |
|  |  |   |  |

Location Machine

Rig up

Drilling and Remarks:

## RECORD

Cased.....in., .....ft.

Sand.....

Gas.....

Oil.....

Total Depth.....

## PRODUCTION

1st 24 hrs. Nat.....

1st 24 hrs. after shot.....

Gas.....Cu. Ft.

Dry Hole.....

Abandoned.....

Date

AUG 7 1929

192

CHAS. L. SHERWOOD

Scout

*Woodson*

Map No. **KANSAS** Sec. *13* Twp. *24* R. *14* <sup>E</sup>

Well No. *1* *Scatt*

*Ellis & Hugg*

Company

Contractor

# CORRECTION

# SECTION PLAT

*750* Ft. from N. Line

\_\_\_\_\_ Ft. from S. Line

\_\_\_\_\_ Ft. from E. Line

*750* Ft. from W. Line

|  |  |   |  |
|--|--|---|--|
|  |  |   |  |
|  |  |   |  |
|  |  | 0 |  |
|  |  |   |  |

Location \_\_\_\_\_

Rig up *Spd.*

Drilling and Remarks:

*first Reported in*  
*13-23-14 E. Coffey Co.*  
*chg to 13-24-14 E*  
*Woodson Co.*

# RECORD

Cased \_\_\_\_\_ in., \_\_\_\_\_ ft.

Sand \_\_\_\_\_

Gas \_\_\_\_\_

Oil \_\_\_\_\_

Total Depth \_\_\_\_\_

# PRODUCTION

1st 24 hrs. Nat. \_\_\_\_\_

1st 24 hrs. after shot \_\_\_\_\_

Gas \_\_\_\_\_ Cu. Ft.

Dry Hole \_\_\_\_\_

Abandoned \_\_\_\_\_

Date

**AUG 1 4 1929**

**CHAS. L. SHERWOOD**

19

Scout

Map No. 18 **KANSAS** Sec. 13 Twp. 23 R. 14 <sup>E</sup>

Well No. 1 **Scott**

Company

Contractor

### CORRECTION

750 Ft. from N. Line

\_\_\_\_\_ Ft. from S. Line

\_\_\_\_\_ Ft. from E. Line

750 Ft. from W. Line

### SECTION PLAT

|  |  |   |  |
|--|--|---|--|
|  |  |   |  |
|  |  |   |  |
|  |  | 0 |  |
|  |  |   |  |

Location \_\_\_\_\_

Rig up Spd & S/D

Drilling and Remarks: \_\_\_\_\_

*This well was  
corrected to Twp  
N. Should be  
Twp 23.*

### RECORD

Cased \_\_\_\_\_ in., \_\_\_\_\_ ft.

Sand \_\_\_\_\_

Gas \_\_\_\_\_

Oil \_\_\_\_\_

Total Depth \_\_\_\_\_

### PRODUCTION

1st 24 hrs. Nat. \_\_\_\_\_

1st 24 hrs. after shot \_\_\_\_\_

Gas \_\_\_\_\_ Cu. Ft.

Dry Hole \_\_\_\_\_

Abandoned \_\_\_\_\_

Date

**AUG 28 1929**

**CHAS. L. SHERWOOD**

19

Scout

KANSAS

Map No. \_\_\_\_\_ Sec. 13 Twp. 73 R. 14Well No. 1 ScottEllis & Hugg

Company

Contractor

COMPLETE

SECTION PLAT

|  |  |   |  |
|--|--|---|--|
|  |  |   |  |
|  |  |   |  |
|  |  | 0 |  |
|  |  |   |  |

750 Ft. from N. Line

\_\_\_\_\_ Ft. from S. Line

\_\_\_\_\_ Ft. from E. Line

750 Ft. from W. Line

Location \_\_\_\_\_

Rig up \_\_\_\_\_

Drilling and Remarks:

Top line 159060/30 Bls

RECORD

Cased \_\_\_\_\_ in., \_\_\_\_\_ ft.

Sand 1612 - 1623

Gas \_\_\_\_\_

Oil \_\_\_\_\_

Total Depth 1623

PRODUCTION

1st 24 hrs. Nat. \_\_\_\_\_

1st 24 hrs. after shot \_\_\_\_\_

Gas \_\_\_\_\_ Cu. Ft.

Dry Hole \_\_\_\_\_

Abandoned \_\_\_\_\_

Date

SEP 25 1929

19

CHAS. L. SHERWOOD

Scout