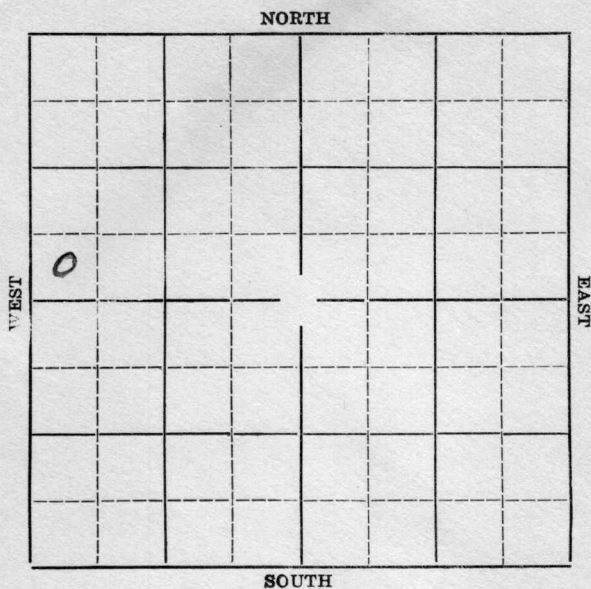


KANSAS

Coffey

Form 51—5M—4-36—Palace

Section 13 Township 23 Range 14-EWell Number #1-ScottCompany Max Reynolds et al

Sec. 13 Twp. 23 R. 14EWell No. #1 Scott FarmMax Reynolds et al Company

Ft. from N. Line


300'~~530'~~

Ft. from S. Line

Ft. from E. Line

300'~~330'~~

Ft. from W. Line

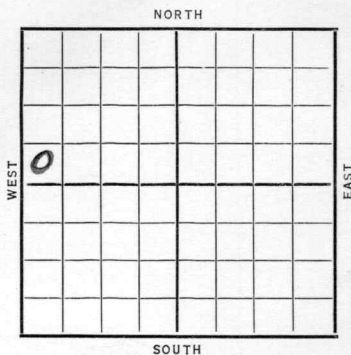Date 1936

REPORT

9/23 Machine.10/1--10/8 Drlg. 1425'.

10/15 Mississippi Lime. 1597'. 6" @ ~~10~~
 1607'. T.D. 1627'. 3000 gallons
 of acid. No test.

10/22 -10/21/36-Miss. L. 1597 bbl

T.D. 1627'.

3000 gallons of acid.

Potential 170 bbls.

COMPLETED

KANSAS

Map No. 17 Sec. 13 Twp. 23 R. 14EWell No. 1 ScottMax Reynolds & Son Company
Contractor

SECTION PLAT

0			

 Ft. from N. Line300 Ft. from S. Line Ft. from E. Line300 Ft. from W. Line

FIRST REPORT

Location Rig up

Drilling and Remarks:

Black.

RECORD

Cased in., ft.Sand Gas Oil Total Depth

PRODUCTION

1st 24 hrs. Nat. 1st 24 hrs. after shot Gas Cu. Ft.Dry Hole Abandoned

Date

SEP 23 1936

19

S. J. LEWIS

Scout

KANSAS

Map No. 17 Sec. 13 Twp. 23 R. 14E

Well No. 1507

Max Reynolds & Co Company
Contractor

SECTION PLAT

0			

_____ Ft. from N. Line

300 Ft. from S. Line

_____ Ft. from E. Line

300 Ft. from W. Line

COMPLETED

Location _____

Rig up _____

Drilling and Remarks:

Test 1597
3000 acid
P 8170

RECORD

Cased _____ in., _____ ft.

Sand _____

Gas _____

Oil _____

Total Depth 1627

PRODUCTION

1st 24 hrs. Nat. _____

1st 24 hrs. after shot _____

Gas _____ Cu. Ft.

Dry Hole _____

Abandoned _____

Date

OCT 21 1936 19

S. J. LEWIS Scout