


Section 14 Township 23 Range 14-E

Well Number #1 Cochran

Company Gillespie

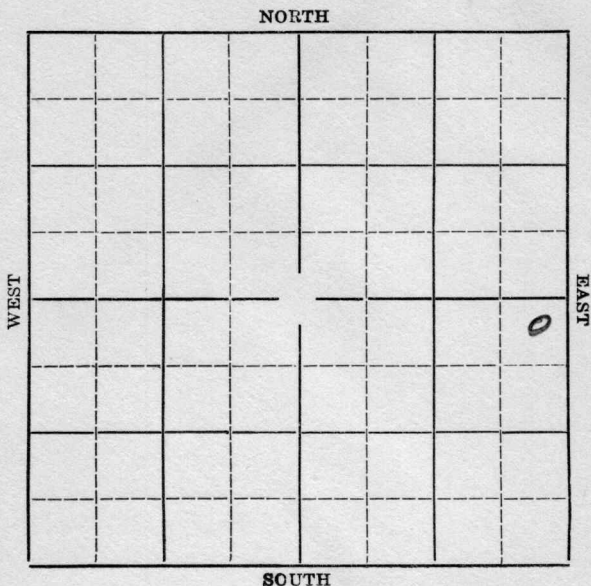

KANSAS

Map No. 17 Sec. 14 Twp. 23 R. 14EWell No. 1 CochranGillespie Company

Contractor

SECTION PLAT

			0

200 Ft. from N. Line

_____ Ft. from S. Line

200 Ft. from E. Line

_____ Ft. from W. Line

FIRST REPORT

Location _____

Rig up _____

Drilling and Remarks:

Rig

RECORD

Cased _____ in., _____ ft.

Sand _____

Gas _____

Oil _____

Total Depth _____

PRODUCTION

1st 24 hrs. Nat. _____

1st 24 hrs. after shot _____

Gas _____ Cu. Ft.

Dry Hole _____

Abandoned _____

Date

NOV 4 1936 19 S. J. LEWIS Scout

KANSAS

Map No. 17 Sec. 14 Twp. 23 R. 14EWell No. 1 CochranGillespie Company

Contractor

SECTION PLAT

			0

200 Ft. from N. Line

_____ Ft. from S. Line

200 Ft. from E. Line

_____ Ft. from W. Line

COMPLETED

Location _____

Rig up _____

Drilling and Remarks:

Miss L 16063000 acidPump 1008th

RECORD

Cased _____ in., _____ ft.

Sand _____

Gas _____

Oil _____

Total Depth 1620

PRODUCTION

1st 24 hrs. Nat. _____

1st 24 hrs. after shot _____

Gas _____ Cu. Ft.

Dry Hole _____

Abandoned _____

Date

DEC 9 1936 19

S. J. LEWIS

Scout