


Greenwood
Map No. *15* *ansas* Sec. *18* Twp. *24* R. *11*
Well No. *1* *Gaffney* Farm
~~*Manhattan Oil*~~ Company
Ward McSinnis NORTH

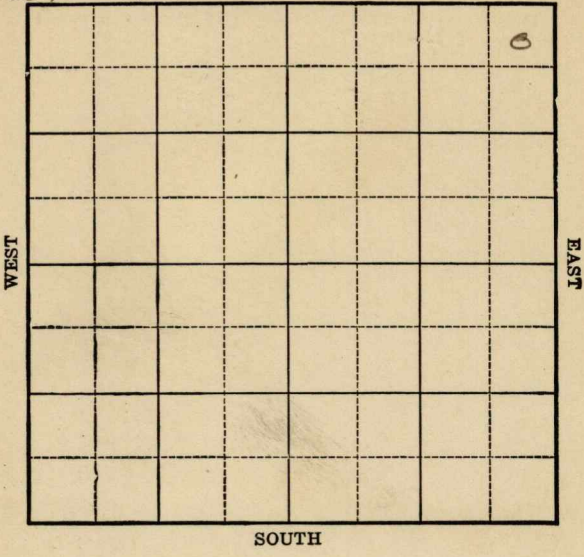

Location _____
Drilling Remarks _____

Rig Up _____
Drilling Remarks _____

RECORD

Cased _____ in. _____ ft.
Sand _____
Gas _____
Oil _____
Total Depth _____

PRODUCTION

1st 24 hrs. Nat. _____
1st 24 hrs. after shot _____
Gas _____ cu. ft.
Dry Hole _____
Abandoned _____

Greenwood

Map No. 17N Sec. 18 Twp. 24 R 11Well No. 1 - Gaffney FarmManhattan et al Company


Ward McSinnis NORTH

330 Ft. from N. Line

Ft. from S. Line

330 Ft. from E. Line

Ft. from W. Line

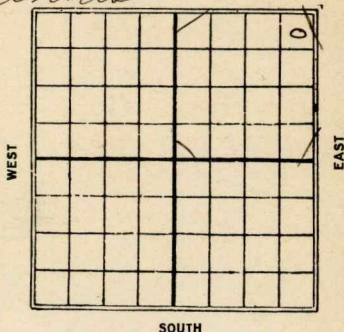

1926

Date

REPORT

8/25 Location

8/31 Day Reg

9/5 Drilg 475

9/22 " 1110

9/29 " 1520

10/13 Sand 1867-1879

P.B. to 1878

40/100 bbls

S. Sherwood

16 **KANSAS** Sec. 18 Twp. 24 R. 11
 Map No. _____
 Well No. 1 Happiness
 Manhattan Oil Co. Company

Contractor

FIRST REPORTS**SECTION PLAT**

330


_____ Ft. from N. Line

_____ Ft. from S. Line

330

_____ Ft. from E. Line

_____ Ft. from W. Line

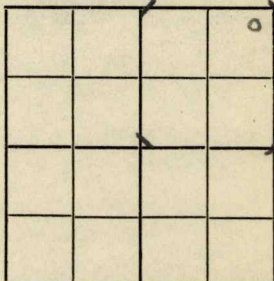

Location ✓ _____

Rig up _____

Drilling and Remarks:

RECORD

Cased _____ in., _____ ft.

Sand _____

Gas _____

Oil _____

Total Depth _____

PRODUCTION

1st 24 hrs. Nat. _____

1st 24 hrs. after shot. _____

Gas _____ Cu. Ft.

Dry Hole _____

Abandoned _____

Date

AUG 25 1926

192


CHAS. L. SHERWOOD

Scout

Sherwood

Map No. *16* **KANSAS** Sec. *18* Twp. *24* R. *11*

Well No. *1* *Saffney* Farm
Manhattan Oil Co Company

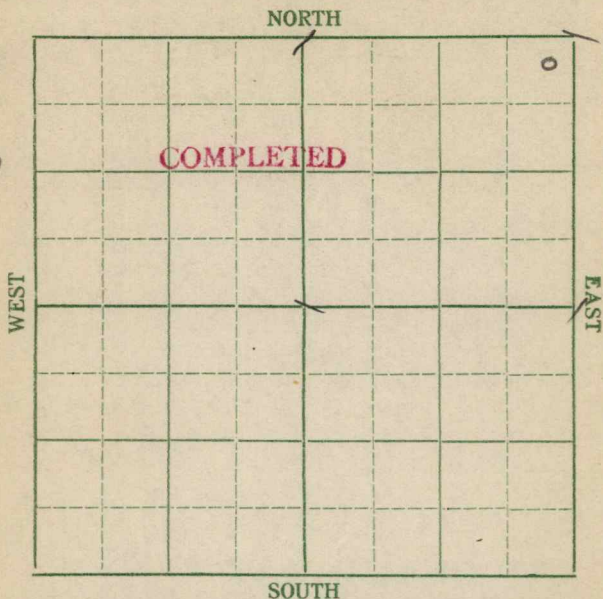

Location _____

Rig up _____

Drilling and Remarks:

Plugged back to 1878'

RECORD

Cased _____ in., _____ ft.
 Sand *1867-1879'*
 Gas _____
 Oil _____
 Total Depth *1879*

PRODUCTION

1st 24 hrs. Nat. _____
 1st 24 hrs. after shot _____
 Gas _____ Cu. Ft.
 Dry Hole _____
 Abandoned _____

49
100 *BS*

Date **OCT 13 1906** **CHAS. L. SHERWOOD**
 192 Scout

16 **KANSAS**Map No. _____ Sec. 18 Twp. 24 R. 11

Well No. _____

Name The Ginnies CompanyCompleted wells Contractor**CORRECTION****SECTION PLAT**

_____ Ft. from N. Line

_____ Ft. from S. Line

_____ Ft. from E. Line

_____ Ft. from W. Line

Location _____

Rig up _____

Drilling and Remarks:

Change Ownershipof this leaseto above.**RECORD**

Cased _____ in., _____ ft.

Sand _____

Gas _____

Oil _____

Total Depth _____

PRODUCTION

1st 24 hrs. Nat. _____

1st 24 hrs. after shot _____

Gas _____ Cu. Ft.

Dry Hole _____

Abandoned _____

Date

SEP 14 1932

CHAS. L. SHERWOOD

192

Scout