


Section 14 Township 23 Range 14E

Well No. #1 Beed (Reed)

Company Olie Barentz

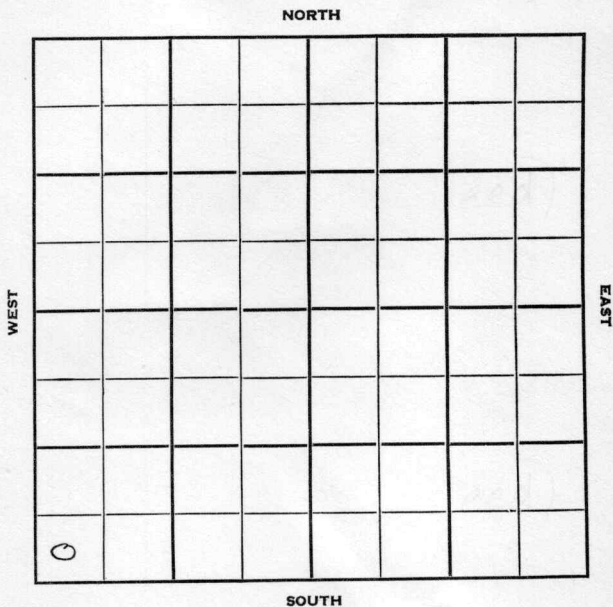

Coffey

KANSAS

Sec. 14 Twp. 23 R. 14E

Well No. #1 Reed Farm

Olie Barentz Company

Alie Barentz - Contr. Contractor


_____ Ft. from N. Line

330' _____ Ft. from S. Line

_____ Ft. from E. Line

330' _____ Ft. from W. Line

SW SW SW (Twin Well)

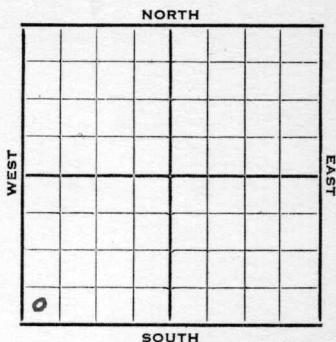

1952

Elev. -

REPORT

8/20

Spud 8-11-52

8" @ 792

Drlg. 820

9/24

Spud 8-11-52

D&A TD 1785

8" @ 792 6" @ 1378

Miss 1639 5" @ 1648

TD 1785 D&A

ABANDONED

County Coffey State Kansas
Sec. 14 (Blk. 23 (Sur. 14E Map No.)
 (Twp.)
Operator Olie Barentz
Well No. 1 Farm Reed
Elev. Location SW SW SW (twin well)

0 FIRST REPORT

330	Ft. From	S	Line	SW
330	Ft. From	W	Line	Quarter

1st. Report **AUG 20 1952**

Completion

Remarks

Alie Barentz - Contr.

Spudding Date 8-11-52

Drlg. Data

8" @ 792 Drlg. 820

J. G. McGEHEE

dry
1646

1944

breaky

low

Check your map: Our maps shows a dry
hole at this spot, same feet measurements
etc. T. D. 1646 drilled in 1949

Advise

Sam

SEP 2 1952

AUG 22 1952

OB

Scout Cards	
Land Small Map	
Land Wall Map	
Tracings	
France Map	
Pierce Map	
Misc	

Drig. Data

County Coffey State KansasSec. 14 (Blk.
Twp.) 23 (Sur.
Rge.) 14E Map No.Operator Olie BarentzWell No. 1 Farm ReedElev. Location SW SW SW330 Ft. From S Line SW330 Ft. From W Line Quarter1st. ReportCompletion SEP 24 1952RemarksOlie Barentz - Contr.Spudding Date 8-11-52Drig. Data D & A TD 17858" @ 792 6" @ 1378 Miss. 16395" @ 1648 TD 1785D & A