

Coffey


~~Woodson~~

KANSAS


Section 14 Township 23 Range 14-E

Well Number 1 - Shotwell

Company Gillispie & Sons

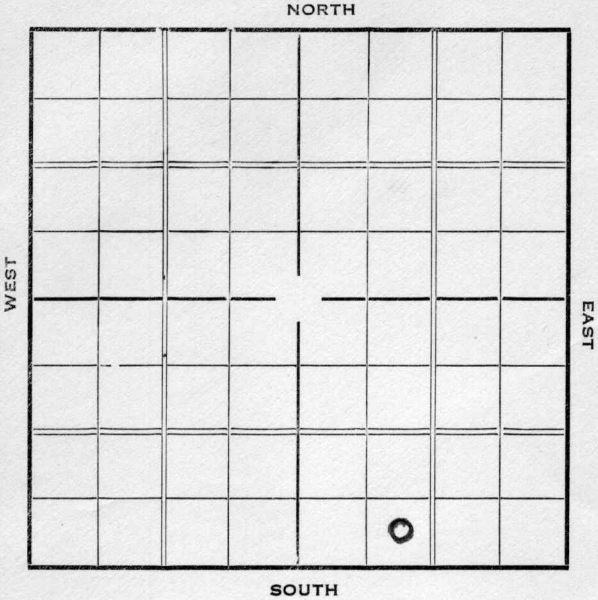

KANSAS

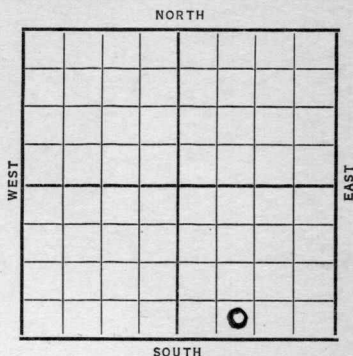Coffey
WoodsonSec. 14 Twp. 23 R. 14-EWell No. #1 Shotwell FarmGillispie & Sons Company Ft. from N. Line330 Ft. from S. Line Ft. from E. Line990 Ft. from W. Line

Date

REPORT

1937

5/19

Standard Rig.

5/28

Spud

6/4

Drlg. 684'.

6/11

10" @ 770'. Drlg. 1125'.

6/19

Drlg. 1500'.

6/25

Burgess 1599'. 6" @ 1615'.

T.D. 1639'. WOC.

7/2

T.D. 1639'. WOC.

7/9

" " "

7/14

6" @ 1615'.

Burgess 1599'.

T.D. 1639'.

3000 acid.

Pot. 20 bbls.

COMPLETED

KANSAS *Woodson*
Map No. 17 Sec. 14 Twp. 23 R. 14 *E*Well No. 1 - Shotwell*Gillispie & Sons* Company

Contractor

FIRST REPORT

 Ft. from N. Line330 Ft. from S. Line Ft. from E. Line990 Ft. from W. Line

SECTION PLAT

Location Rig up

Drilling and Remarks:

*Standard
Rig*

RECORD

Cased in., ft.Sand Gas Oil Total Depth

PRODUCTION

1st 24 hrs. Nat. 1st 24 hrs. after shot Gas Cu. Ft.Dry Hole Abandoned

Date

MAY 19 1937

19

H. D. Hatfield

Scout

KANSAS

Map No. 17 Sec. 14 Twp. 23 R. 14 ^EWell No. 1-ShatwellGillispie & Sons Company

Contractor

CORRECTION

SECTION PLAT

			0

540 Ft. from N. Line330 Ft. from S. Line

_____ Ft. from E. Line

990 Ft. from W. Line

Location _____

Rig up _____

Drilling and Remarks:

*Given out as
being in
Woodson County*

RECORD

Cased _____ in., _____ ft.

Sand _____

Gas _____

Oil _____

Total Depth _____

PRODUCTION

1st 24 hrs. Nat. _____

1st 24 hrs. after shot _____

Gas _____ Cu. Ft.

Dry Hole _____

Abandoned _____

Date

5-211937H. B. Hatfield

Scout

KANSAS

Map No. 17 Sec. 14 Twp. 23 R. 14 ^EWell No. 1-ShattwellGillispie & Sons Company

Contractor

COMPLETED

SECTION PLAT

_____ Ft. from N. Line

330 Ft. from S. Line

_____ Ft. from E. Line

990 Ft. from W. Line

Location _____

Rig up _____

Drilling and Remarks:

3000 AcidPat- 20

RECORD

Cased 6 in., 1615 ft.Sand Burgess 1599

Gas _____

Oil _____

Total Depth 1639

PRODUCTION

1st 24 hrs. Nat. _____

1st 24 hrs. after shot _____

Gas _____ Cu. Ft.

Dry Hole _____

Abandoned _____

Date

JUL 14 1937

19

H. D. Hatfield

Scout