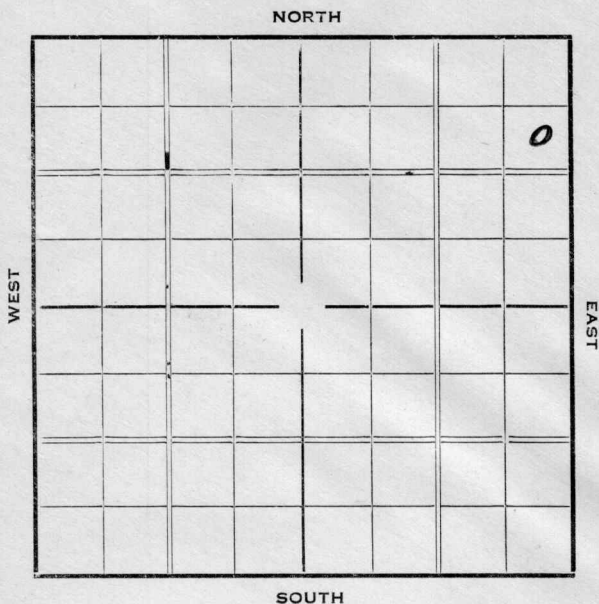


Coffey
KANSASSection 14 Township 23 Range 14EWell Number 2 WileyCompany Harrigan Bros.

KANSAS

Map No. 17 Sec. 14 Twp. 23 R. 14EWell No. 2. WileyHarrigan Bros Company

Contractor

SECTION PLAT

			0

990 Ft. from N. Line

_____ Ft. from S. Line

330 Ft. from E. Line

_____ Ft. from W. Line

FIRST REPORT

Location _____

Rig up _____

Drilling and Remarks:

Wack

RECORD

Cased _____ in., _____ ft.

Sand _____

Gas _____

Oil _____

Total Depth _____

PRODUCTION

1st 24 hrs. Nat. _____

1st 24 hrs. after shot _____

Gas _____ Cu. Ft.

Dry Hole _____

Abandoned _____

Date

DEC 9 1936 19

S. J. LEWIS Scout

Map No. 17 Sec. 14 Twp. 23 R. 14E

Well No. 2 Wiley

Harrison Bros. Company
Contractor

SECTION PLAT

			o

990 Ft. from N. Line

_____ Ft. from S. Line

330 Ft. from E. Line

_____ Ft. from W. Line

COMPLETED

Location _____

Rig up _____

Drilling and Remarks:

Miss L 1584
Pay 1605-15
8000 acid
70 4 1/2

RECORD

Cased _____ in., _____ ft.

Sand _____

Gas _____

Oil _____

Total Depth 1615

PRODUCTION

1st 24 hrs. Nat. _____

1st 24 hrs. after shot _____

Gas _____ Cu. Ft.

Dry Hole _____

Abandoned _____

Date

JAN 20 1937 19

S. J. LEWIS Scout