

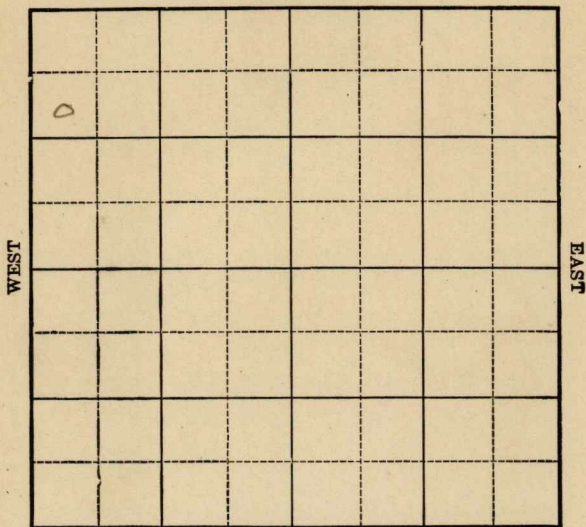
*Greenwood*

Map No. *157N* Sec. *20* Twp. *24* R. *11*

Well No. *1* *Thomas* Farm

*Robertson & Dugan* Company

NORTH



SOUTH

Location \_\_\_\_\_

Drilling Remarks

Rig Up \_\_\_\_\_

Drilling Remarks

RECORD

Cased \_\_\_\_\_ in. \_\_\_\_\_ ft.

Sand \_\_\_\_\_

Gas \_\_\_\_\_

Oil \_\_\_\_\_

Total Depth \_\_\_\_\_

PRODUCTION

1st 24 hrs. Nat. \_\_\_\_\_

1st 24 hrs. after shot \_\_\_\_\_

Gas \_\_\_\_\_ cu. ft.

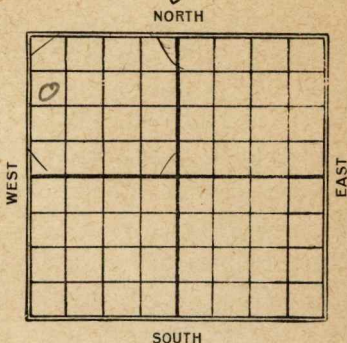
Dry Hole \_\_\_\_\_

Abandoned \_\_\_\_\_

Map No. 11 Sec. 20 Twp. 24 R. 11Well No. 1 Thomas Farm  
Robertson & Lugo company990 Ft. from N. Line

Ft. from S. Line

Ft. from E. Line

330 Ft. from W. Line1926

Date

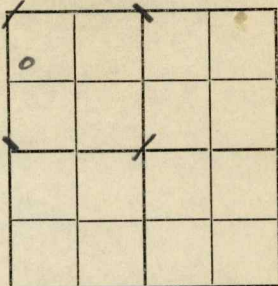
REPORT

9/15 R.O.G.  
 9/22 rigging up  
 9/29 Spudding  
 10/13 Drlg 1782'  
 10/20 Sdy shale 1830-39  
 R.O.G. 2010

*Greenwood*  
 Map No. 16 **KANSAS** Sec. 20 Twp. 24 R. 11  
 Well No. 1 *Thomas*  
Robertson & Dugan Company  
 Contractor

**FIRST REPORTS**

990 Ft. from N. Line  
 \_\_\_\_\_ Ft. from S. Line  
 \_\_\_\_\_ Ft. from E. Line  
330 Ft. from W. Line

**SECTION PLAT**

Location \_\_\_\_\_  
 Rig up \_\_\_\_\_  
 Drilling and Remarks:

*Bob*

**RECORD**

Cased \_\_\_\_\_ in., \_\_\_\_\_ ft.  
 Sand \_\_\_\_\_  
 Gas \_\_\_\_\_  
 Oil \_\_\_\_\_  
 Total Depth \_\_\_\_\_

**PRODUCTION**

1st 24 hrs. Nat. \_\_\_\_\_  
 1st 24 hrs. after shot \_\_\_\_\_  
 Gas \_\_\_\_\_ Cu. Ft.  
 Dry Hole \_\_\_\_\_  
 Abandoned \_\_\_\_\_

Date

SEP 15 1926

192

**CHAS. L. SHERWOOD**

Scout

16 **KANSAS** 20 24 11  
 Map No. \_\_\_\_\_ Sec. \_\_\_\_\_ Twp. \_\_\_\_\_ R. \_\_\_\_\_

Well No. *Thomas*  
*Robertson & Dugon* Company

Contractor

**COMPLETED**

**SECTION PLAT**

|   |  |  |  |
|---|--|--|--|
| 0 |  |  |  |
|   |  |  |  |
|   |  |  |  |
|   |  |  |  |

990 Ft. from N. Line

\_\_\_\_\_ Ft. from S. Line

\_\_\_\_\_ Ft. from E. Line

330 Ft. from W. Line

**ABANDONED**

Location \_\_\_\_\_

Rig up \_\_\_\_\_

Drilling and Remarks:

*Sdy Shab 1830-39*

*2010*

**RECORD**

Cased \_\_\_\_\_ in., \_\_\_\_\_ ft.

Sand \_\_\_\_\_

Gas \_\_\_\_\_

Oil \_\_\_\_\_

Total Depth *2010*

**PRODUCTION**

1st 24 hrs. Nat. \_\_\_\_\_

1st 24 hrs. after shot \_\_\_\_\_

Gas \_\_\_\_\_ Cu. Ft.

Dry Hole ☒

Abandoned ☒

Date

**OCT 20 1926**

**CHAS. L. SHERWOOD**

192

Scout