


Form 51—5M—10-26—Mid-West *woodson*
Map No. _____ Sec. *16* Twp. *23* R. *14 E*
Well No. *1 - Pilcher* Farm _____
Harper oil co Company _____

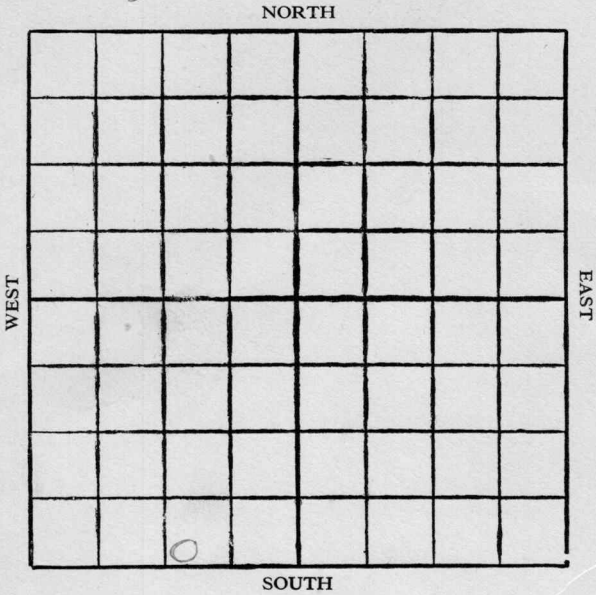

Location _____
Drilling Remarks _____

Rig Up _____
Drilling Remarks _____

RECORD

Cased _____ in. _____ ft.
Sand _____
Gas _____
Oil _____
Total Depth _____

PRODUCTION


1st 24 hrs. Nat. _____
1st 24 hrs. after shot _____
Gas _____ cu. ft.
Dry Hole _____
Abandoned _____

Woodson

Map No. _____ Sec. 16 Twp. 23 R. 14 E

Well No. 1- Pilcher Farm
Harper Oil Company

NORTH

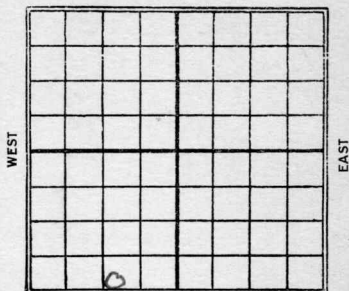

SOUTH

_____ Ft. from N. Line

250 Ft. from S. Line

1070 Ft. from E. Line

_____ Ft. from W. Line

1927

Date

REPORT

Date	REPORT
6/8	Rigging up
6/15	Drly 850
6/22	" 1050
6/29	" 1300
7/13	Top line 1646
	U. & A. 1705'
	T. & D. 1705'

Map No. _____ Sec. *16* Twp. *23* R. *14*

Well No. *1* _____
Pilcher
Harpers Oil Co. Company

Contractor _____

FIRST REPORTS

SECTION PLAT

_____ Ft. from N. Line

250 _____ Ft. from S. Line

1070 _____ Ft. from E. Line

_____ Ft. from W. Line

Location _____

Rig up _____

Drilling and Remarks:

Rigging up.

RECORD

Cased _____ in., _____ ft.

Sand _____

Gas _____

Oil _____

Total Depth _____

PRODUCTION

1st 24 hrs. Nat. _____

1st 24 hrs. after shot _____

Gas _____ Cu. Ft.

Dry Hole _____

Abandoned _____

Date

JUN 8 1927 CHAS. L. SHERWOOD
 1927 Scout

Coffee 23

KANSAS

Map No. _____ Sec. 16 Twp. 23 R. 14

Well No. 1 Filcher _____

Harper & Co _____ Company

_____ Contractor

COMPLETED

_____ Ft. from N. Line

250 _____ Ft. from S. Line

1070 _____ Ft. from E. Line

_____ Ft. from W. Line

ABANDONED

SECTION PLAT

	0		

Location _____

Rig up _____

Drilling and Remarks:

200 line 1646

RECORD

Cased _____ in., _____ ft.

Sand _____

Gas _____

Oil _____

Total Depth 1705 _____

PRODUCTION

1st 24 hrs. Nat. _____

1st 24 hrs. after shot _____

Gas _____ Cu. Ft.

Dry Hole ✓ _____

Abandoned ✓ _____

Date

July 13 1927

CHAS. L. SHERWOOD

Scout