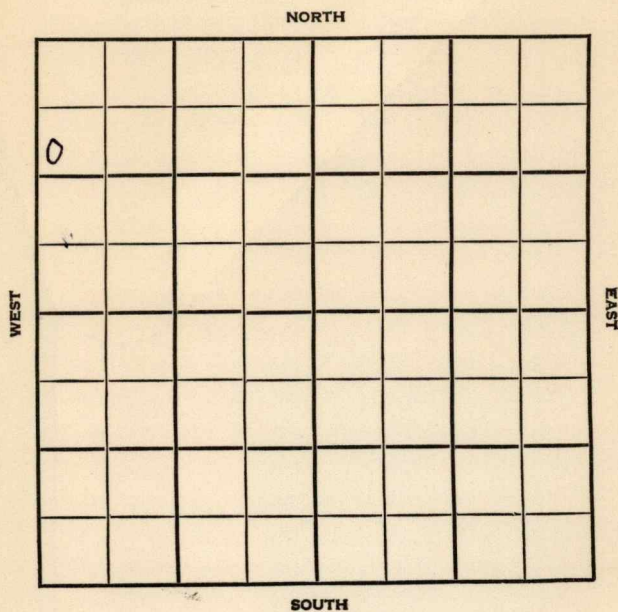


Section 29 Township 24 Range 11EWell No. #3 LindamoodCompany Rockhill & Uhl

Greenwood

KANSAS

SEC.	TWP.	R.
29	24	11E

WELL NO.

3 Lindamood

FARM

COMPANY

Rockhill & Uhl

CONTRACTOR

Uhl

Wiggins


_____ Ft. from N. Line

_____ Ft. from S. Line

_____ Ft. from E. Line

_____ Ft. from W. Line

SW NW NW

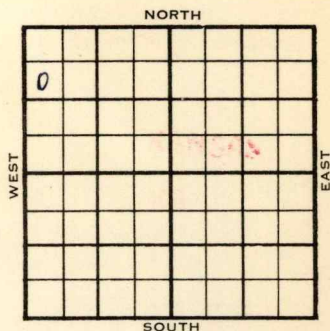

	ELEVATION	REPORT
1955		

6/22 4" @ 1579
 CO to 1592
 A Peru 1579
 TD 1592
 sd-frac

6/29 Comp. 40 bopd
 Tops:
 A. Peru 1579
 TD. 1592

COMPLETED

County Greenwood Elev. _____
 Sec. 29 Twp. 24 Rge. 11E
 Company Rockhill & Uhl
 Farm Name Lindemood No. 3

TOPS	DEPTH	LOG	DATUM
Anh.			
T.P.			
H.			
Tr.			
Dg.			
B.L.			
L.			
K.C.			
B.K.C.			
Ce.			
C.			
M.			
M.			
K.			
Mz.			
Mq.			
V.			
S.			
S.			
A	Peru	1579	
R.			
Pe.			
G.			
I.D.	1592		

Loc. in Sec. _____

SW NW NW

Geol. _____

Contr. _____

Uhl

Pool _____

Wiggins

0		

FIRST REPORT
JUN 22 '55

Date Comm. _____

4" @ 1579 CO to 1592 sd-frac

Co.

Lse.

No.

Sec.

T.

R.

CountyGreenwoodElev.

Sec.29Twp.24Rge.11E

CompanyRockhill & Uhl

FarmNameLindamoodNo.3

TOPS	DEPTH	LOG	DATUM	Loc. in Sec.
Anh.				SW NW NW
Tp.				
H.				
Tr.				
Dg.				
Bl.				
L.				
K.C.				Geol.
B.K.C.				Contr.
Ce.				Uhl
C.				
M.				
M.				Pool
K.				Wiggins
Mz.				
Mq.				
V.				
S.				
S.				
A	Peru	1579		
R.				
Pe.				
G.				
	4	1579		
T.D.	1592			

Date Comm.

JUN 29 1955

4" @ 1579CO to 1592sd-frac

Comp. 40 bopd