


Map No. 17 Sec. 23 Twp. 14 R. 14

Well No. 1-Draper Farm Cross Company etal

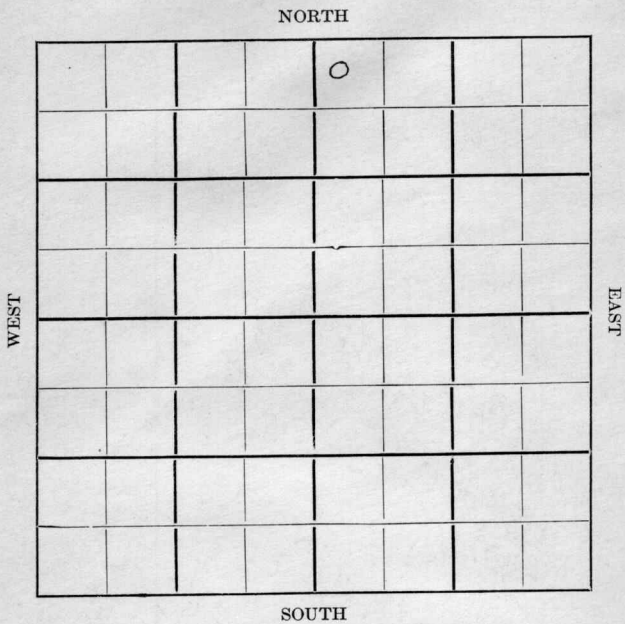

Location.....
Drilling Remarks.....
.....
.....
RECORD

Cased..... in..... ft.
Sand.....
Gas.....
Oil.....
Total Depth.....

Rig Up.....
Drilling Remarks.....
.....
.....
PRODUCTION

1st 24 hrs. Nat.....
1st 24 hrs. after shot.....
Gas..... cu. ft.....
Dry Hole.....
Abandoned.....


Map No. *KANSAS* Sec. *17* Twp. *23* R. *14*
 Well No. *1-Draper* Farm
Cross et al Company

250 Ft. from N. Line

..... Ft. from S. Line

..... Ft. from E. Line

250 Ft. from W. Line

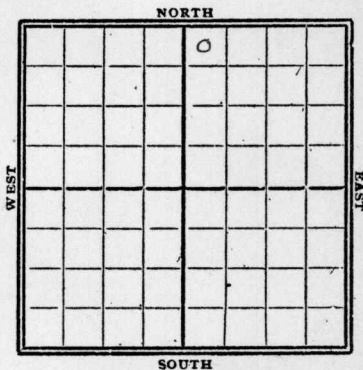

1929

Date

REPORT

6/12 *Secd 1500-08*
Top line 1697
TD. 1755- HFW
Dry & Abandoned

Copy
 17 **KANSAS** Map No. _____ Sec. *17* Twp. *23* R. *14*

Well No. *1* *Draper*
Cross et al _____ Company

FIRST REPORTS

Contractor _____

COMPLETE**SECTION PLAT**

750 _____ Ft. from N. Line

_____ Ft. from S. Line

_____ Ft. from E. Line

750 _____ Ft. from W. Line

		0	

ABANDONED

Location _____

Rig up _____

Drilling and Remarks:

Sand 1500-1508
top line 1697'

Dr 1755
AFW

RECORD

Cased _____ in., _____ ft.

Sand _____

Gas _____

Oil _____

Total Depth *1755'***PRODUCTION**

1st 24 hrs. Nat. _____

1st 24 hrs. after shot _____

Gas _____ Cu. Ft.

Dry Hole ☒Abandoned ☒

Date

JUN 12 1929

192

CHAS. L. SHERWOOD

Scout