


Map No. _____ Sec. 16 Twp. 23 R. 14
Well No. 2- Peak Farm _____
Harper Oil Company _____

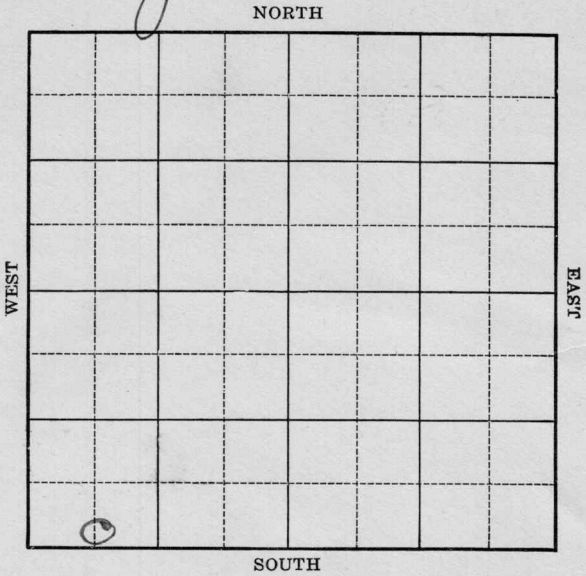

Location _____
Drilling Remarks _____

Rig Up _____
Drilling Remarks _____

RECORD

Cased _____ in. _____ ft.
Sand _____
Gas _____
Oil _____
Total Depth _____

PRODUCTION

1st 24 hrs. Nat. _____
1st 24 hrs. after shot _____
Gas _____ cu. ft.
Dry Hole _____
Abandoned _____

Map No. KANSAS Sec. 16 Twp. 23 R. 14 E

Well No. 2- Peak Farm
Harper Oil Co Company

NORTH

_____ Ft. from N. Line

200 Ft. from S. Line

_____ Ft. from E. Line

660 Ft. from W. Line

WEST

EAST

SOUTH

1928

Date

REPORT

5/10 machine

5/18

5/24 Drilg 800

5/31 1628-1645'-T.D.

Top line 1613'
60/20 bbl

Woodson

no tracing
KANSASMAP NO. _____ SEC. 16 TWP. 23 R. 14 ^EWELL NO. 2 Peak

Harper Oil Co.

COMPANY

CONTRACTOR

FIRST REPORTS

SECTION PLAT

0			

Ft. FROM N. LINE

200

Ft. FROM S. LINE

Ft. FROM E. LINE

660

Ft. FROM W. LINE

LOCATION Machine

RIG UP _____

DRILLING AND REMARKS:

RECORD

CASED _____ IN. _____ FT.

SAND _____

GAS _____

OIL _____

TOTAL DEPTH _____

PRODUCTION

1ST 24 HRS. NAT. _____

1ST 24 HRS. AFTER SHOT _____

GAS _____ CU. FT.

DRY HOLE _____

ABANDONED _____

DATE

MAY 10 1928

CHAS. L. SHERWOOD

192

SCOUT

Woodson

KANSAS

MAP No. _____ SEC. 16 TWP. 23 R. 14

WELL No. 2

Harper Oil Co COMPANY

CONTRACTOR

SECTION PLAT

COMPLETED

_____ FT. FROM N. LINE

700 _____ FT. FROM S. LINE

_____ FT. FROM E. LINE

660 _____ FT. FROM W. LINE

0			

RECORD

LOCATION _____

CASED _____ IN. _____ FT.

RIG UP _____

SAND 1628-1645

DRILLING AND REMARKS:

GAS _____

OIL _____

TOTAL DEPTH 1645

PRODUCTION

1ST 24 HRS. NAT. _____

1ST 24 HRS. AFTER SHOT _____

GAS _____ CU. FT.

DRY HOLE _____

ABANDONED _____

DATE

MAY 31 1928

192

CHAS. L. SHERWOOD

SCOUT