


KANSAS

Map No. _____ Sec. 16 Twp. 23 R. 14
 Well No. 37 Peak Farm _____
Harper Oil Company

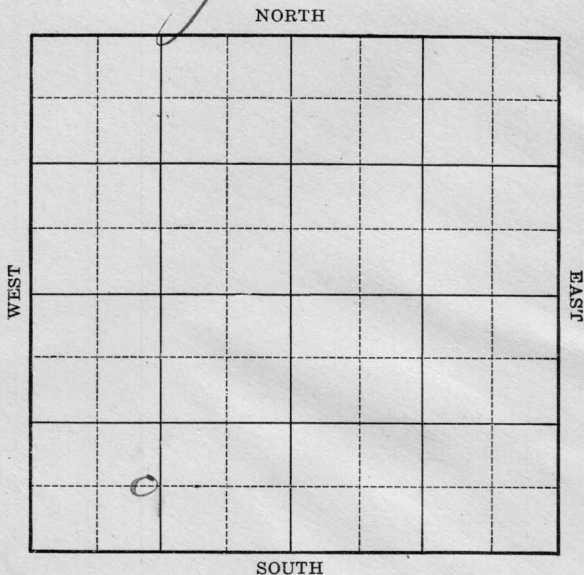

Location _____

Drilling Remarks _____

Rig Up _____

Drilling Remarks _____

RECORD

Cased _____ in. _____ ft.

Sand _____

Gas _____

Oil _____

Total Depth _____

PRODUCTION

1st 24 hrs. Nat. _____

1st 24 hrs. after shot _____

Gas _____ cu. ft.

Dry Hole _____

Abandoned _____

Map No. KANSAS Sec. 16 Twp. 23 R. 14Well No. 3- Peak Farm
Harper oil Company


_____ Ft. from N. Line

660 Ft. from S. Line

_____ Ft. from E. Line

1120 Ft. from W. Line1928

NORTH

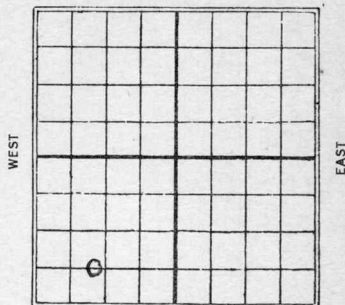

SOUTH

Date

REPORT

6/20 4m ch.6/287/6 Drlg 1140-7/13 1620-40 T.D. 1645T.L. 160260/25 bbb

KANSAS

MAP No. no 2111 SEC. 16 TWP. 23 R. 14WELL No. 3 PeakCOMPANY Harper Oil Co

CONTRACTOR

SECTION PLAT

FIRST REPORTS

Ft. FROM N. LINE

660 Ft. FROM S. LINE

Ft. FROM E. LINE

1120 Ft. FROM W. LINE

0			

LOCATION Machining

RIG UP

DRILLING AND REMARKS:

RECORD

CASED _____ IN. _____ FT.

SAND _____

GAS _____

OIL _____

TOTAL DEPTH _____

PRODUCTION

1ST 24 HRS. NAT. _____

1ST 24 HRS. AFTER SHOT _____

GAS _____ CU. FT.

DRY HOLE _____

ABANDONED _____

DATE

JUN 20 1928 CHAS. L. SHERWOOD

192

SCOUT

MAP NO. 16 SEC. 23 TWP. 14

WELL NO. 3

Harger oil & gas COMPANY

CONTRACTOR

COMPLETED

SECTION PLAT

Ft. FROM N. LINE

660 Ft. FROM S. LINE

Ft. FROM E. LINE

1170 Ft. FROM W. LINE

LOCATION

RIG UP

DRILLING AND REMARKS:

TL 1602

607 25 BS

RECORD

CASED 1620-40 IN. 40 FT.

SAND

GAS

OIL

TOTAL DEPTH 1645

PRODUCTION

1ST 24 HRS. NAT.

1ST 24 HRS. AFTER SHOT

GAS CU. FT.

DRY HOLE

ABANDONED

DATE

7/13/28

192

Sherwood

SCOUT