

Greenwood

KANSAS

SECTION 20 TOWNSHIP 24 RANGE 11 E

WELL NO. #7 Robertson

COMPANY Beaumont Pet.

NORTH

0							

WEST

EAST

SOUTH

Greenwood

KANSAS

SEC.	TWP.	R.
20	24	11E

WELL NO.

#7 Robertsen

FARM

COMPANY

Beaumont Petr.

CONTRACTOR

H.J. Uhl

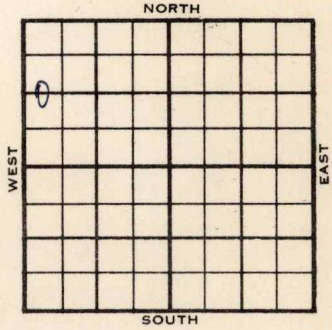
Wiggins

Ft. from N. Line

Ft. from S. Line

Ft. from E. Line

Ft. from W. Line

 $W\frac{1}{2}$ $W\frac{1}{2}$ NW

	ELEVATION	REPORT
--	-----------	--------

1955

12-21

Drlg. 1285

County Greenwood Elev. _____
 Sec. 20 Twp. 24 Rge. 11E
 Company Beaumont Pet.
 Farm Name Robertson No. 7

TOPS	DEPTH	LOG	DATUM
Anh.			
Tr.			
H.			
Tr.			
Dg.			
Bl.			
L.			
K.C.			
B.K.C.			
Ce.			
C.			
M.			
M.			
K.			
Mz.			
Me.			
V.			
S.			
S.			
A.			
R.			
Pe.			
G.			
T.D.			

Loc. in Sec.

W¹/₂ W¹/₂ NW

Geol.

Contr.

H.J. Uhl

Pool

Wiggins

DEC 21 '55

FIRST REPORT

Date Comm.

drlg. 1285