

Map No. _____ Sec 16 Twp 27 R 4Well No. 17 Sully Farm _____Prairie Company _____

NORTH

WEST

EAST

SOUTH

Location _____

Rig Up 12-4-16

Drilling Remarks:

Drilling Remarks:

12/11 =290 = 12/18450 = 12/282000 = 1/8/172225 = 1/15

RECORD

Cased _____ in _____ Ft.

S and _____

Gas _____

Oil _____

Total Depth _____

PRODUCTION

1st 24 hrs. Nat _____

1st 24 hrs. after shot _____

Gas _____ Cu. Ft.


Dry Hole _____

Abandoned _____

Map No. _____ Sec. 16 Twp. 27 R. 4Well No. 17 Sully Farm __________
Company _____

NORTH

WEST

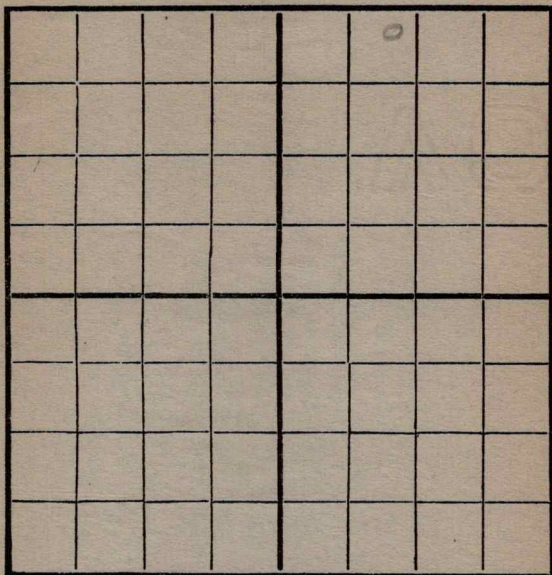

EAST

SOUTH

Location _____

Rig Up ☒ _____

Drilling and remarks _____

RECORD

Cased _____ in. _____ Ft.

Sand _____

Gas _____

Oil _____

Total Depth _____

PRODUCTION

1st 24 hrs. Nat. _____

1st 24 hrs. after shot _____

Gas _____ Cu. Ft.

Dry Hole _____

Abandoned _____

Date

12/4, 1916, Cardiff Scout

Map No. _____ Sec. 16 Twp. 27 R. 4Well No. 17 Sully Farm __________
Prairie Company

NORTH

WEST

EAST

SOUTH

Location _____

Rig Up _____

Drilling and remarks _____

RECORD

Cased _____ in. _____ Ft.

Sand _____

Gas _____

Oil _____

Total Depth _____

PRODUCTION

1st 24 hrs. Nat. _____

1st 24 hrs. after shot _____

Gas _____ Cu. Ft.

Dry Hole _____

Abandoned _____


Date

12/11, 1916, Cardiff Scout

Map No. _____ Sec. 16 Twp. 27 R. 4
Well No. 17 Scully Farm _____
Prairie Company _____

NORTH

WEST

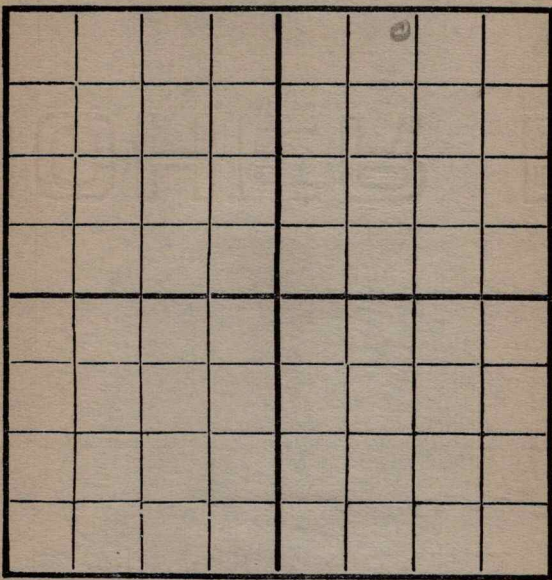

EAST

SOUTH

Location _____
Rig Up _____
Drilling and remarks _____

290'

RECORD

Cased _____ in. _____ Ft.
Sand _____
Gas _____
Oil _____
Total Depth _____

PRODUCTION


1st 24 hrs. Nat. _____
1st 24 hrs. after shot _____
Gas _____ Cu. Ft.
Dry Hole _____
Abandoned _____

Date 12/18, 1916 Cordery Scout _____

Map No. _____ Sec. 16 Twp. 27 R. 4Well No. 17 South Farm _____

Company _____

NORTH

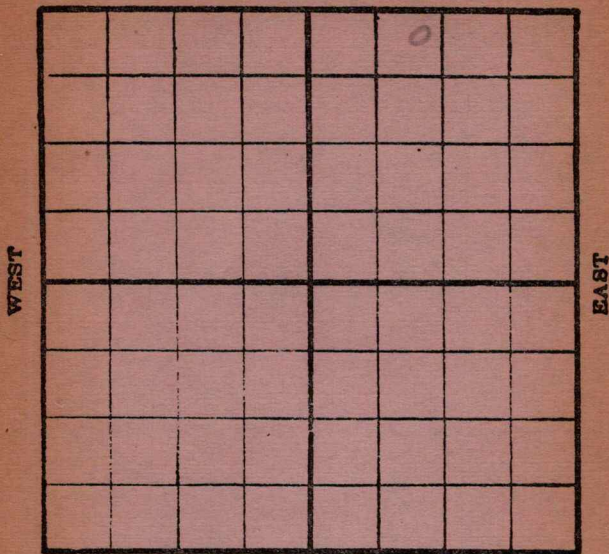

SOUTH

Location _____

Rig up _____

Drilling and remarks:

450

RECORD

Cased _____ in. _____ Ft.

Sand _____

Gas _____

Oil _____

Total Depth _____

PRODUCTION

1st. 24 hrs. Nat. _____

1st. 24 hrs. after shot _____

Gas _____ Cu. Ft.

Dry Hole _____

Abandoned _____

Date

12/28/1916, Conrad Scout

Map No. _____ Sec. 16 Twp. 27 R. 4
 Well No. 17 Scout Farm
Pioneer Company

NORTH

WEST						0		EAST

SOUTH

Location _____
 Rig Up _____
 Drilling and remarks

1470

RECORD

Cased _____ in. _____ Ft.
 Sand _____
 Gas _____
 Oil _____
 Total Depth _____

PRODUCTION

1st 24 hrs. Nat. _____
 1st 24 hrs. after shot _____
 Gas _____ Cu. Ft.
 Dry Hole _____
 Abandoned _____


Date

1/1, 1917 Scout Scout

Map No. _____ Sec. 16 Twp. 27 R. 4Well No. 17 Scully Farm __________Prairie Company _____

NORTH

WEST

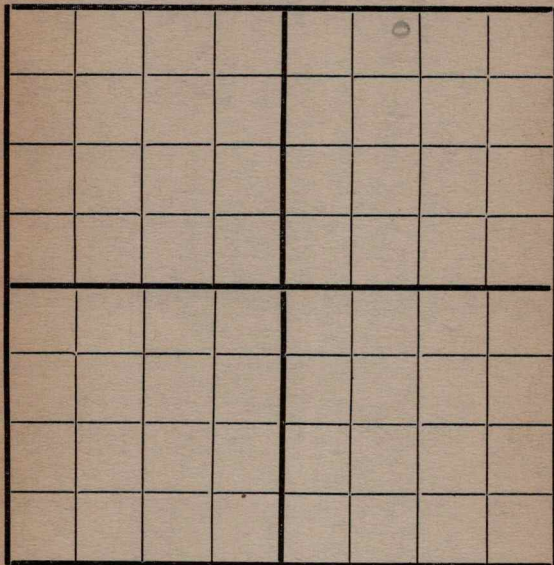

EAST

SOUTH

Location _____

Rig Up _____

Drilling and remarks

Good

RECORD

Cased _____ in. _____ Ft.

Sand _____

Gas _____

Oil _____

Total Depth _____

PRODUCTION

1st 24 hrs. Nat. _____

1st 24 hrs. after shot _____

Gas _____ Cu. Ft.

Dry Hole _____

Abandoned _____

Date

1/8, 1917 Scully Scout

Map No. _____ Sec. 16 Twp. 22 R. 4
 Well No. 17 Sully Farm _____
Prosser Company _____

NORTH

WEST

EAST

SOUTH

Location _____

Rig Up _____

Drilling and remarks

2225

RECORD

Cased _____ in. _____ Ft.

Sand _____

Gas _____

Oil _____

Total Depth _____

PRODUCTION

1st 24 hrs. Nat. _____

1st 24 hrs. after shot _____

Gas _____ Cu. Ft.

Dry Hole _____

Abandoned _____

Date

1/15, 1917


C. J. [Signature] Scout

Map No. _____ Sec. 16 Twp. 27 R. 4
 Well No. 17 _____ Farm _____
 _____ Prainie Company _____

NORTH

WEST

EAST

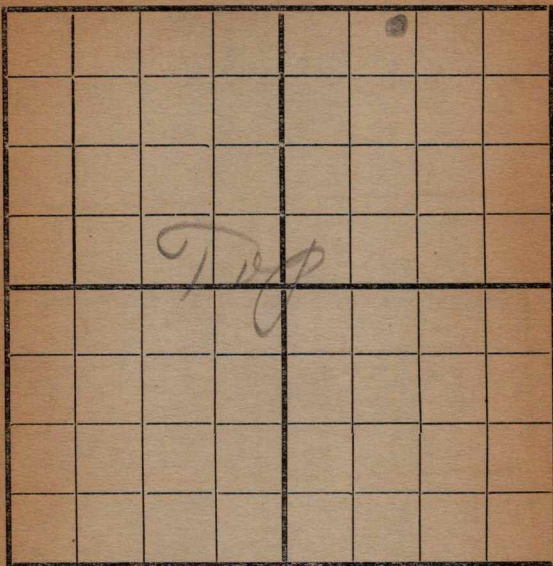

SOUTH

Location _____

Rig Up _____

Drilling and remarks

Top sand 2438
Pay 2490
Drilling 2496
500' oil
in hole

RECORD

Cased _____ in. _____ Ft.

Sand _____

Gas _____

Oil _____

Total Depth _____

PRODUCTION

1st 24 hrs. Nat. _____

1st 24 hrs. after shot _____

Gas _____ Cu. Ft.

Dry Hole _____

Abandoned _____


Date

4/25, 1917 Car. Dr. Co. Scout

L 1001
 Map No. K11 Sec. 16 Twp. 27 R. 4
 Well No. 17 sandy Farm
Primer Company

NORTH

WEST

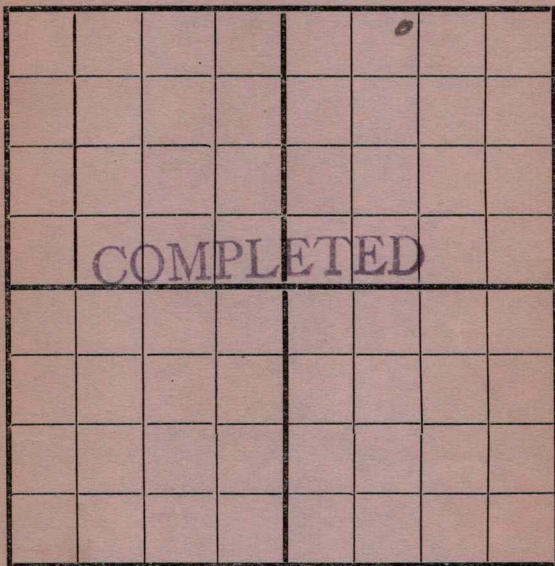

EAST

SOUTH

Location

Rig Up

Drilling and remarks

2438-2482- no show
 2482-2545 small

showing

2545-2560-

Big pay-

Estimated

at 500 Bbls

RECORD

Cased in. Ft.

Sand 2438 - 2560

Gas

Oil

Total Depth

PRODUCTION

1st 24 hrs. Nat.

1st 24 hrs. after shot

Gas Cu. Ft.

Dry Hole

Abandoned

Date

1/29/1917


Cordry

Scout

Map No. _____ Sec. 16 Twp. 27 R. 4
 Well No. 17 Scully Farm _____
Prairie Company _____

NORTH

WEST

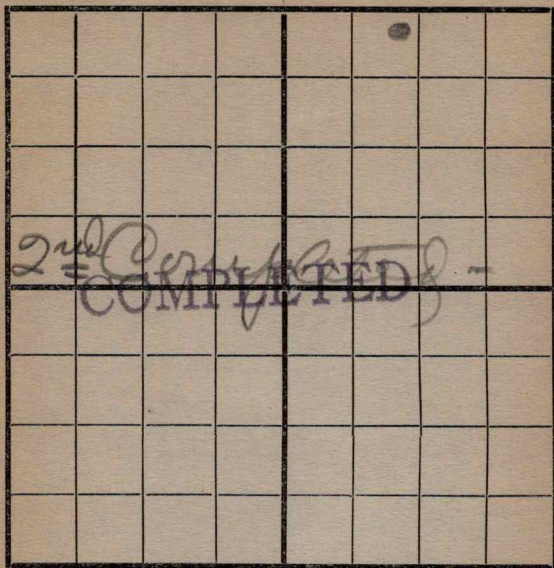

EAST

SOUTH

Location _____

Rig Up _____

Drilling and remarks _____

2nd Completion
 in Jan 29 as follows

2438-2482 no show

2482-2545 300 feet

oil in hole

Best Pay 2545-2560

Est at 500 Bbls

since then they have

Date

2/5, 1917 Cardiff Scout

RECORD

Cased _____ in. _____ Ft.

Sand 2438-2464

Gas _____

Oil _____

Total Depth _____

PRODUCTION

1st 24 hrs. Nat. _____

1st 24 hrs. after shot _____

Gas _____ Cu. Ft.

Dry Hole _____

Abandoned _____