


Section 29 Township 24 Range 11E  
 Well No. #1 Lindamood  
 Company Braden et al

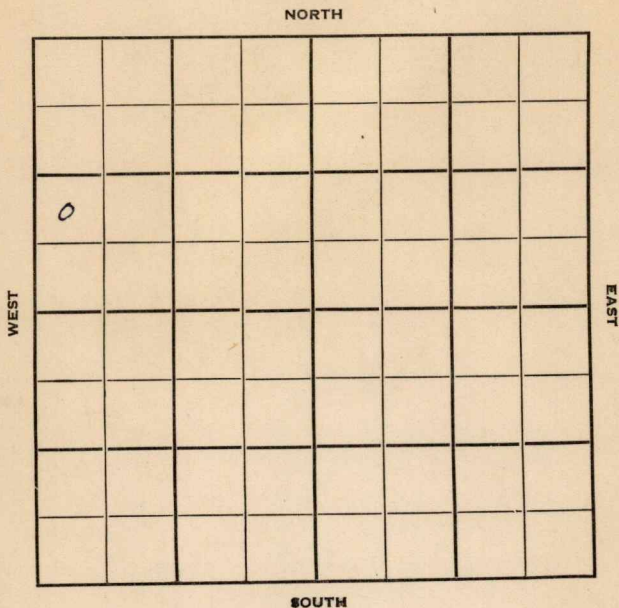

Greenwood **KANSAS**

Sec. 29 Twp. 24 R. 11E

Well No. #1 Lindamood Farm

Braden et al Company

Contractor

Miscellaneous


           Ft. from N. Line

990' Ft. from S. Line

           Ft. from E. Line

330' Ft. from W. Line

NW SW NW

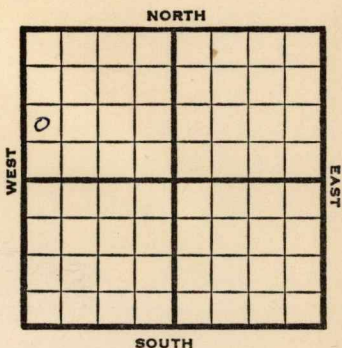

1950

REPORT

4/12

8" @ 40'  
**Prue sand 1556'**  
TD 1570'  
4½" @ 1557'

5/17

8" @40  
**Pru sd 1556**  
4½" @ 1557  
TD 1575  
shot 30 qts nitro  
1560-75  
11 BOPD  
Completed

**COMPLETED**


Map No. \_\_\_\_\_ Sec. 29 Twp. 24 R. 11EWell No. 1 Lindamood

\_\_\_\_\_ Braden et al. \_\_\_\_\_ Company

\_\_\_\_\_ Contractor

NW SW NW

## SECTION PLAT

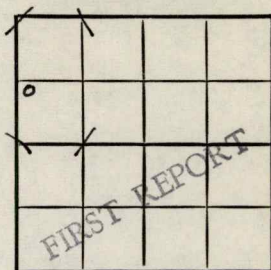

\_\_\_\_\_ Ft. from N. Line

990 \_\_\_\_\_ Ft. from S. Line

\_\_\_\_\_ Ft. from E. Line

330 \_\_\_\_\_ Ft. from W. Line

Greenwood County

Location \_\_\_\_\_

Rig up \_\_\_\_\_

Drilling and Remarks:

8" @ 40

Pru sand 1556

TD 1570

4 $\frac{1}{2}$ " @ 1557

## RECORD

Cased \_\_\_\_\_ in., \_\_\_\_\_ ft.

Sand \_\_\_\_\_

Gas \_\_\_\_\_

Oil \_\_\_\_\_

Total Depth \_\_\_\_\_

## PRODUCTION

1st 24 hrs. Nat. \_\_\_\_\_

1st 24 hrs. after shot \_\_\_\_\_

Gas \_\_\_\_\_ Cu. Ft.

Dry Hole \_\_\_\_\_

Abandoned \_\_\_\_\_

Date

APR 12 1950

19

J. E. TYRA

Scout

Map No. \_\_\_\_\_ Sec. 29 Twp. 24 R. 11E

Well No. 1 Lindamood

Braden etal. Company

Contractor

NW SW NW


SECTION PLAT

\_\_\_\_\_ Ft. from N. Line

990 Ft. from S. Line

\_\_\_\_\_ Ft. from E. Line

330 Ft. from W. Line

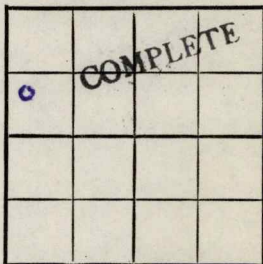

Greenwood

Location \_\_\_\_\_

Rig up \_\_\_\_\_

Drilling and Remarks:

*8" @ 40  
Pm Sd. 1556  
4 1/2" @ 1557  
T.D. 1575  
shot 30 gts nitro*

RECORD

Cased \_\_\_\_\_ in., \_\_\_\_\_ ft.

Sand \_\_\_\_\_

Gas \_\_\_\_\_

Oil \_\_\_\_\_

Total Depth \_\_\_\_\_

PRODUCTION

1st 24 hrs. Nat. \_\_\_\_\_

1st 24 hrs. after shot \_\_\_\_\_

Gas \_\_\_\_\_ Cu. Ft.

Dry Hole \_\_\_\_\_

Abandoned \_\_\_\_\_

Date

*1560-75*

*11 BOPD.*

MAY 17 1950

J. E. TYRA

Scout