

Map No. _____ Sec. 16 Twp. 27 R. 4
 Well No. 18 Sully Farm _____
Pravie Company _____

NORTH

WEST



EAST

SOUTH

Location ✓ ✓Rig Up 12-4-16

Drilling Remarks:

12/11-12/22-12/28-1/8/17-1/15-

Drilling Remarks:

RECORD

Cased _____ in _____ Ft.
 Sand _____
 Gas _____
 Oil _____
 Total Depth _____


PRODUCTION

1st 24 hrs. Nat. _____
 1st 24 hrs. after shot _____
 Gas _____ Cu. Ft.
 Dry Hole _____
 Abandoned _____

Map No. _____ Sec. 16 Twp. 27 R. 4
 Well No. 18 Sully Farm _____
Prairie Company _____

NORTH

WEST

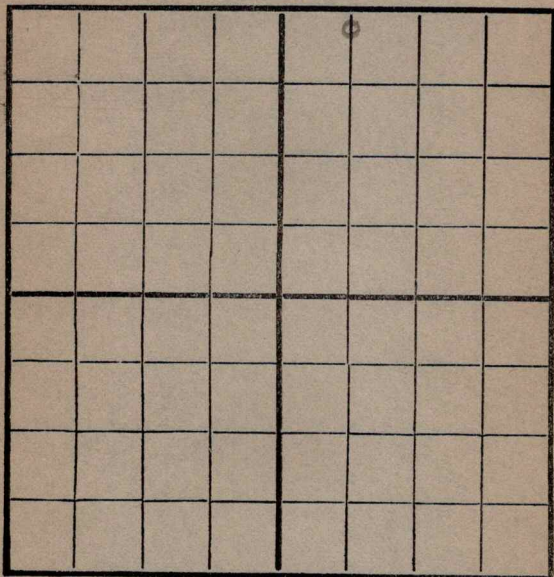

EAST

SOUTH

Location _____
 Rig Up _____
 Drilling and remarks _____

RECORD

Cased _____ in. _____ Ft.
 Sand _____
 Gas _____
 Oil _____
 Total Depth _____

PRODUCTION

1st 24 hrs. Nat. _____
 1st 24 hrs. after shot _____
 Gas _____ Cu. Ft.
 Dry Hole _____
 Abandoned _____

Date

12/11, 1916, Cordiff Scout

Map No. _____ Sec. 16 Twp. 27 R. 4Well No. 18 Sandy Farm _____Prairie Company _____

NORTH

WEST

EAST

SOUTH

Location ✓Rig Up ✓

Drilling and remarks

RECORD

Cased _____ in. _____ Ft.

Sand _____

Gas _____

Oil _____

Total Depth _____

PRODUCTION

1st 24 hrs. Nat. _____

1st 24 hrs. after shot _____

Gas _____ Cu. Ft.

Dry Hole _____

Abandoned _____


Date

12/4, 1916, Cordell Scout

Map No. _____ Sec. 16 Twp. 27 R. 4Well No. 12 Sandy Farm __________
Company _____

NORTH

WEST

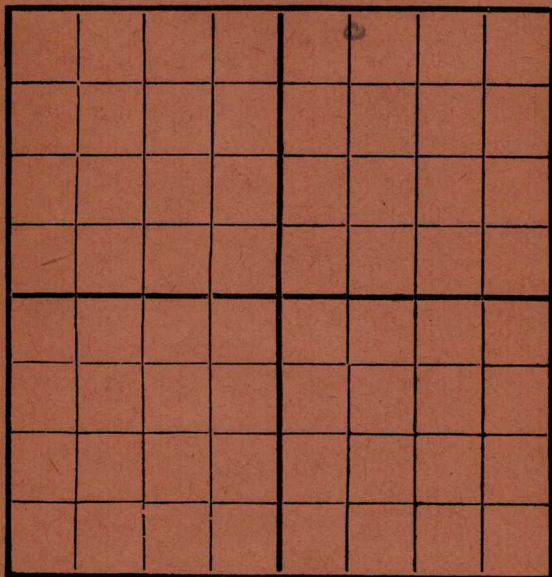

EAST

SOUTH

RECORD

Location _____

Cased _____ in. _____ Ft.

Rig Up ☒ _____

Sand _____

Drilling and remarks _____

Gas _____

Oil _____

Total Depth _____

PRODUCTION

1st 24 hrs. Nat. _____

1st 24 hrs. after shot _____

Gas _____ Cu. Ft.

Dry Hole _____

Abandoned _____


Date

12/18, 1916 C. C. Cady Scout

Map No. _____ Sec. 16 Twp. 27 R. 4Well No. 18 Sandy Farm __________
Primitive Company

NORTH

WEST

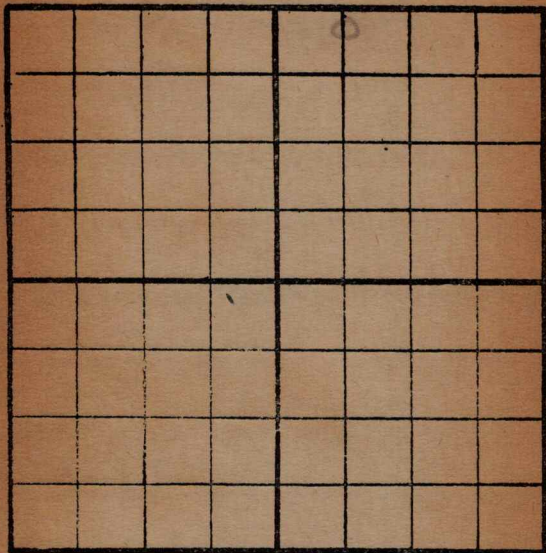

EAST

SOUTH

Location _____

Rig up ☒ _____

Drilling and remarks:

RECORD

Cased _____ in. _____ Ft.

Sand _____

Gas _____

Oil _____

Total Depth _____

PRODUCTION

1st. 24 hrs. Nat. _____

1st. 24 hrs. after shot. _____

Gas _____ Cu. Ft.

Dry Hole _____


Abandoned _____

Date

12/28, 1916, 6 Cardup Scout

Map No. _____ Sec. 16 Twp. 27 R. 4
 Well No. 18 Scully Farm _____
Prairie Company _____

NORTH

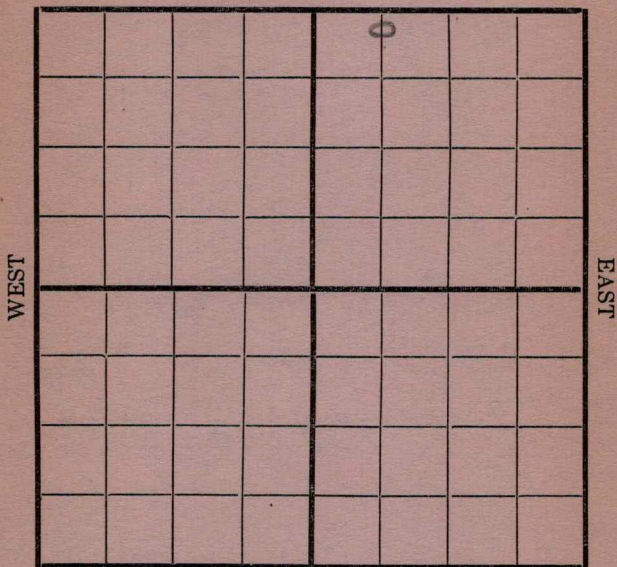

SOUTH

Location _____
 Rig Up ☒ _____
 Drilling and remarks _____

RECORD

Cased _____ in. _____ Ft.
 Sand _____
 Gas _____
 Oil _____
 Total Depth _____

PRODUCTION

1st 24 hrs. Nat. _____
 1st 24 hrs. after shot _____
 Gas _____ Cu. Ft.
 Dry Hole _____
 Abandoned _____

Date


1/1, 1917 Scully Scout

Map No. _____ Sec. 16 Twp. 27 R. 4
 Well No. 18 Landly Farm _____
Prairie Company _____

NORTH

WEST

EAST

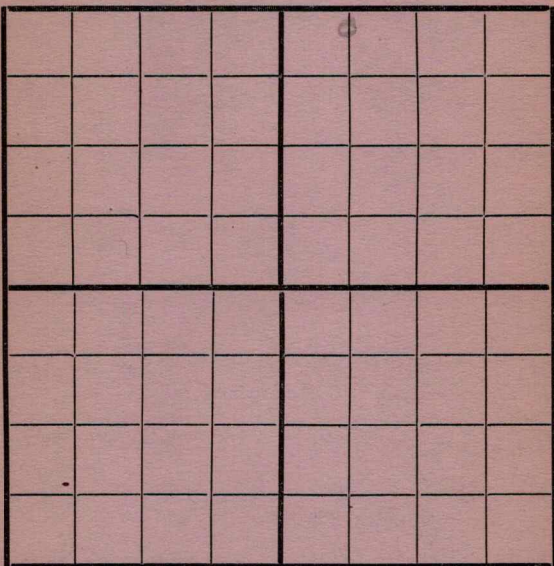

SOUTH

Location _____
 Rig Up ✓ _____
 Drilling and remarks _____

RECORD

Cased _____ in. _____ Ft.
 Sand _____
 Gas _____
 Oil _____
 Total Depth _____

PRODUCTION

1st 24 hrs. Nat. _____
 1st 24 hrs. after shot _____
 Gas _____ Cu. Ft.
 Dry Hole _____
 Abandoned _____

Date 1/8, 1917 Landly Scout

Map No. _____ Sec. 16 Twp. 27 R. 4
 Well No. 18 Sully Farm _____
Pruned Company _____

NORTH

WEST

EAST

SOUTH

Location _____
 Rig Up ✓ _____
 Drilling and remarks _____

RECORD

Cased _____ in. _____ Ft.
 Sand _____
 Gas _____
 Oil _____
 Total Depth _____


PRODUCTION

1st 24 hrs. Nat. _____
 1st 24 hrs. after shot _____
 Gas _____ Cu. Ft.
 Dry Hole _____
 Abandoned _____

Date 1/15, 1917 Cordell Scout _____

Map No. _____ Sec. 16 Twp. 27 R. 4
 Well No. 18 Sandy Farm _____
Providence Company _____

NORTH

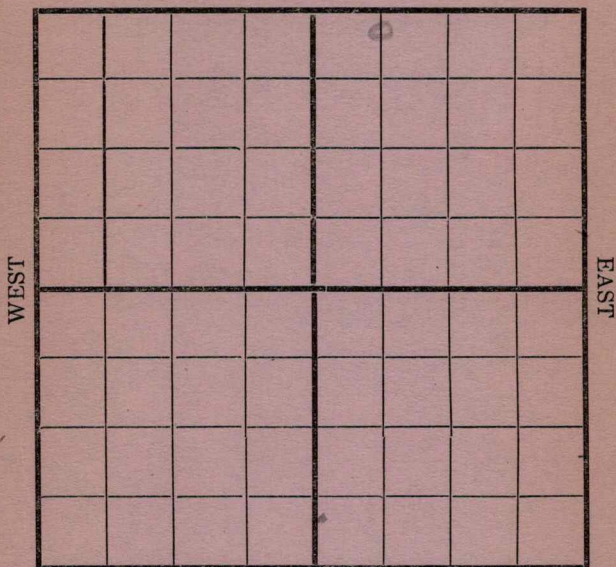

SOUTH

Location _____

Rig Up _____

Drilling and remarks _____

RECORD

Cased _____ in. _____ Ft.

Sand _____

Gas _____

Oil _____

Total Depth _____

PRODUCTION

1st 24 hrs. Nat. _____

1st 24 hrs. after shot _____

Gas _____ Cu. Ft.

Dry Hole _____


Abandoned _____

Date

1/22, 1917 Candy Scout

Map No. _____ Sec. 16 Twp. 27 R. 4
 Well No. 18 Sully Farm _____
Provincetown Company _____

NORTH

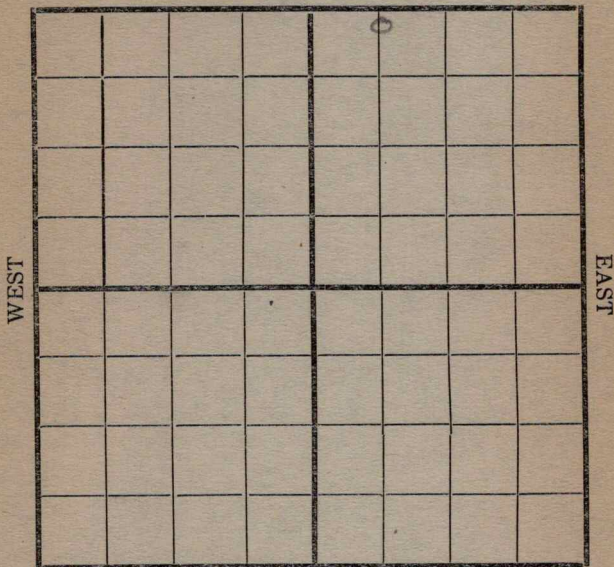

SOUTH

Location _____

Rig Up ☒ _____

Drilling and remarks _____

RECORD

Cased _____ in. _____ Ft.

Sand _____

Gas _____

Oil _____

Total Depth _____

PRODUCTION

1st 24 hrs. Nat. _____

1st 24 hrs. after shot _____

Gas _____ Cu. Ft.

Dry Hole _____

Abandoned _____

Date

1/31, 1912 C. Sully Scout

Map No. _____ Sec. 16 Twp. 27 R. 4
 Well No. 18 Scully Farm _____
Promis Company _____

NORTH

WEST

EAST

SOUTH

Location _____

Rig Up ☒ _____

Drilling and remarks _____

RECORD

Cased _____ in. _____ Ft.

Sand _____

Gas _____

Oil _____

Total Depth _____

PRODUCTION

1st 24 hrs. Nat. _____

1st 24 hrs. after shot _____

Gas _____ Cu. Ft.

Dry Hole _____

Abandoned _____

Date

85 ; 191 7 Scully Scout

Map No. _____ Sec. 16 Twp. 22 R. 4
Well No. 18 Sandy Farm _____
Prairie Company _____

NORTH

WEST								EAST


SOUTH

Location _____ Rig Up <u>✓</u> _____ Drilling and remarks _____	RECORD
	Cased _____ in. _____ Ft.
	Sand _____
	Gas _____
	Oil _____
	Total Depth _____
	PRODUCTION
	1st 24 hrs. Nat. _____
	1st 24 hrs. after shot _____
	Gas _____ Cu. Ft.
	Dry Hole _____
	Abandoned _____

Date 2/2 1912 Condy Scout

Map No. _____ Sec. 16 Twp. 22 R. 4
 Well No. 18 Seely Farm _____
Prosser Company _____

NORTH

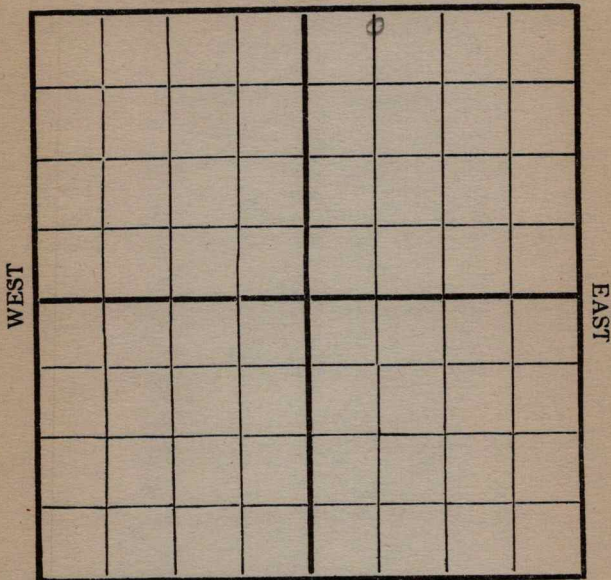

SOUTH

Location _____
 Rig Up _____
 Drilling and remarks _____

RECORD

Cased _____ in. _____ Ft.
 Sand _____
 Gas _____
 Oil _____
 Total Depth _____

PRODUCTION

1st 24 hrs. Nat. _____
 1st 24 hrs. after shot _____
 Gas _____ Cu. Ft.
 Dry Hole _____
 Abandoned _____


Date

191

Scout

Map No. _____ Sec. 16 Twp. 27 R. 4
 Well No. 18 Sandy Farm _____
Prarie Company _____

NORTH

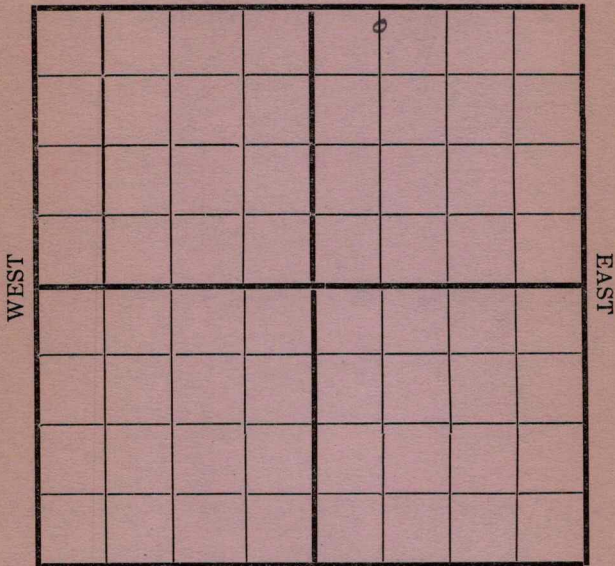

SOUTH

Location _____
 Rig Up _____
 Drilling and remarks _____

Spending

RECORD

Cased _____ in. _____ Ft.
 Sand _____
 Gas _____
 Oil _____
 Total Depth _____

PRODUCTION

1st 24 hrs. Nat. _____
 1st 24 hrs. after shot _____
 Gas _____ Cu. Ft.
 Dry Hole _____
 Abandoned _____


Date

2/26 191 7 *Sandy* Scout

Map No. _____ Sec. 16 Twp. 27 R. 4

Well No. 18 Scully Farm _____
Prairie Company _____

NORTH

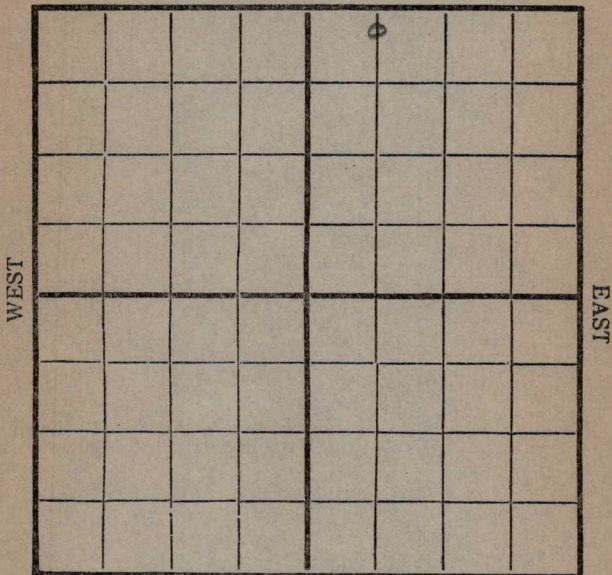

SOUTH

REMARKS:


400'

Date

3-5-1917 Carroll Scout

Map No. _____ Sec. 16 Twp. 27 R. 4
Well No. 18 Seely Farm _____
Prairie Company _____


NORTH

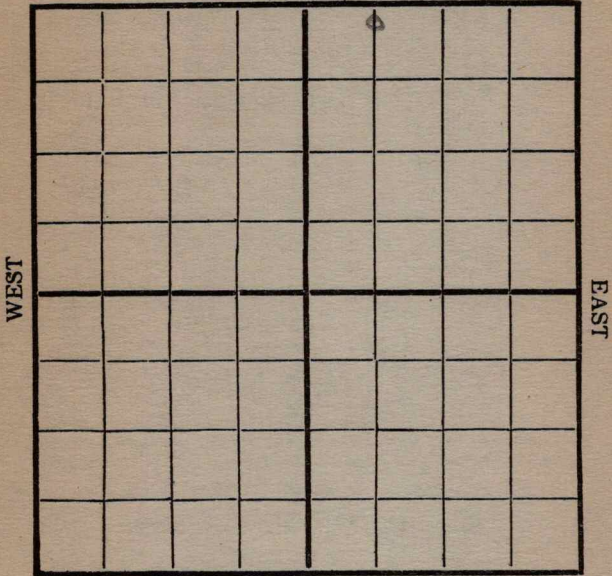

SOUTH

	RECORD
Location _____	Cased _____ in. _____ Ft.
Rig Up _____	Sand _____
Drilling and remarks	Gas _____
<u>Fishing</u> <u>750'</u>	Oil _____
	Total Depth _____
	PRODUCTION
	1st 24 hrs. Nat. _____
	1st 24 hrs. after shot _____
	Gas _____ Cu. Ft.
	Dry Hole _____
	Abandoned _____

Date 3/12, 1917 C. Seely Scout

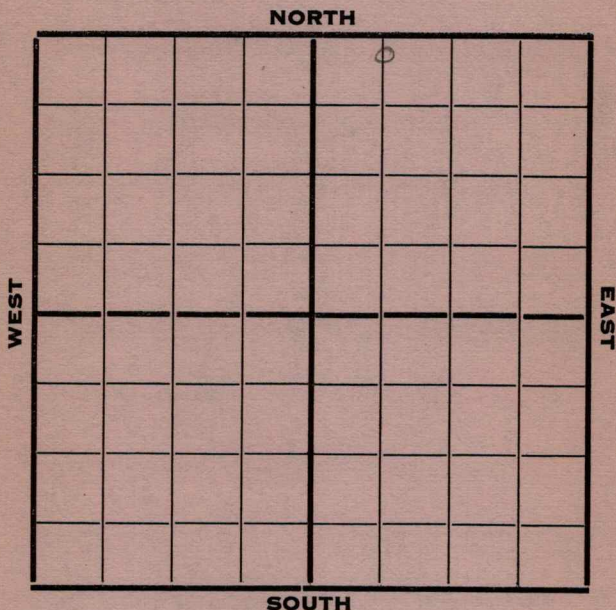Map No. Sec. 16 Twp. 27 R. 4Well No. 18 Saulty Farm
Prairie Company

Location

Rig up

Drilling and Remarks:

Fishing
750'

RECORD

Cased in. Ft.

Sand

Gas

Oil

Total Depth

PRODUCTION

1st 24 hrs. Nat.

1st 24 hrs. after shot

Gas..... Cu. Ft.

Dry Hole

Abandoned

Date


3/19, 1917 Condy Scout

Map No. _____ Sec. 16 Twp. 27 R. 4
 Well No. 18 Sully Farm _____
Pisunil Company _____

NORTH

750

WEST

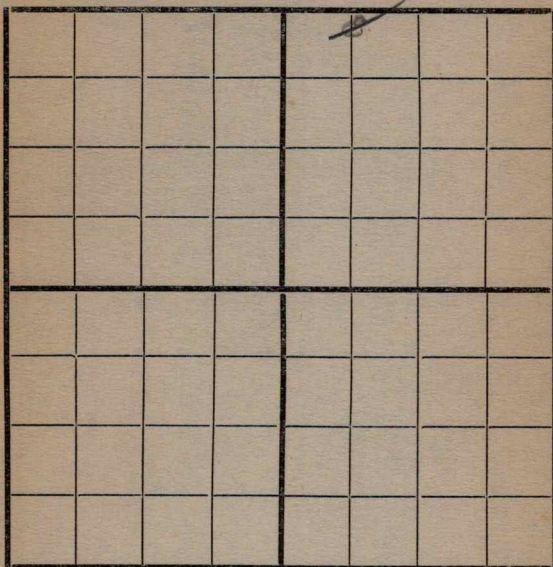

EAST

SOUTH

Location _____

Rig Up _____

Drilling and remarks

*Skipped Rig
 from old
 hole that had
 fishing job at
 750*

RECORD

Cased _____ in. _____ Ft.

Sand _____

Gas _____

Oil _____

Total Depth _____

PRODUCTION

1st 24 hrs. Nat. _____

1st 24 hrs. after shot _____

Gas _____ Cu. Ft.

Dry Hole _____

Abandoned _____

Date


3/26, 1912 Cand Scout

Map No. _____ Sec. 16 Twp. 27 R. 4
 Well No. 18 Danell Farm _____
Prairie Company _____

NORTH

WEST

EAST

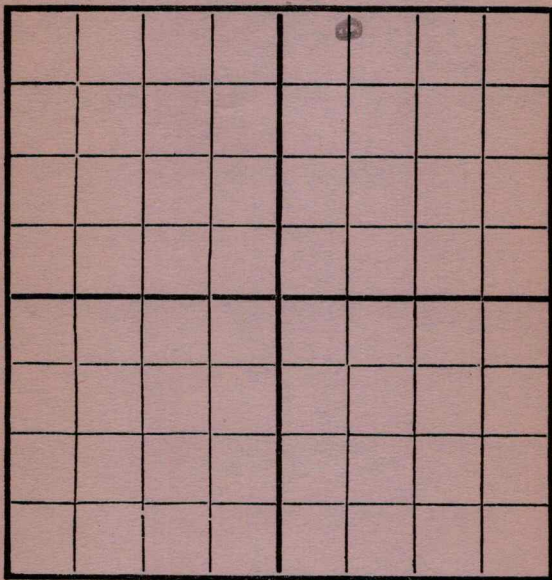

SOUTH

Location _____

Rig Up _____

Drilling and remarks

Spudding

RECORD

Cased _____ in. _____ Ft.

Sand _____

Gas _____

Oil _____

Total Depth _____

PRODUCTION

1st 24 hrs. Nat. _____

First 24 hrs. after shot _____

Gas _____ Cu. Ft.

Dry Hole _____

Abandoned _____

Date

4/4, 1917 Danell Scout

Map No. _____ Sec. 16 Twp. 27 R. 4
 Well No. 18 Scully Farm _____
Prime Company _____

NORTH

WEST

EAST

SOUTH

Location _____

Rig Up _____

Drilling and remarks

RECORD

Cased _____ in. _____ Ft.

Sand _____

Gas _____

Oil _____

Total Depth _____

PRODUCTION

1st 24 hrs. Nat. _____

1st 24 hrs. after shot _____

Gas _____ Cu. Ft.

Dry Hole _____

Abandoned _____

Date

4/10, 1917 Scully Scout

Map No. _____ Sec. 16 Twp. 27 R. 4
 Well No. 18 Sully Farm _____
Prinice Company _____

NORTH

WEST

EAST

SOUTH

Location _____
 Rig Up _____
 Drilling and remarks _____

1370'

RECORD

Cased _____ in. _____ Ft.
 Sand _____
 Gas _____
 Oil _____
 Total Depth _____


PRODUCTION

1st 24 hrs. Nat. _____
 1st 24 hrs. after shot _____
 Gas _____ Cu. Ft.
 Dry Hole _____
 Abandoned _____

Date 4/17, 1917 Cardiff Scout

Map No. _____ Sec. 16 Twp. 27 R. 4
 Well No. 18 Scully Farm _____
Pioneer Company _____

NORTH

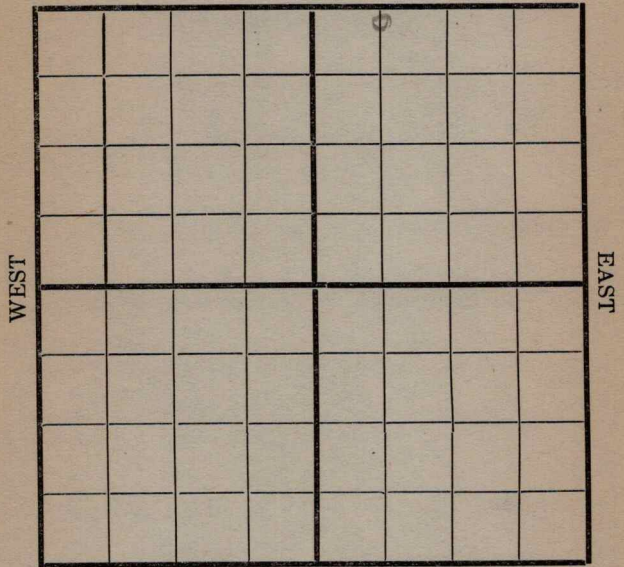

SOUTH

Location _____
 Rig Up _____
 Drilling and remarks _____

1900'

RECORD

Cased _____ in. _____ Ft.
 Sand _____
 Gas _____
 Oil _____
 Total Depth _____

PRODUCTION

1st 24 hrs. Nat. _____
 1st 24 hrs. after shot _____
 Gas _____ Cu. Ft.
 Dry Hole _____
 Abandoned _____


Date 4/24, 1917 Conley Scout

Map No. _____ Sec. 16 Twp. 27 R. 4
 Well No. 18 Sully Farm _____
Princed Company _____

NORTH

WEST

EAST

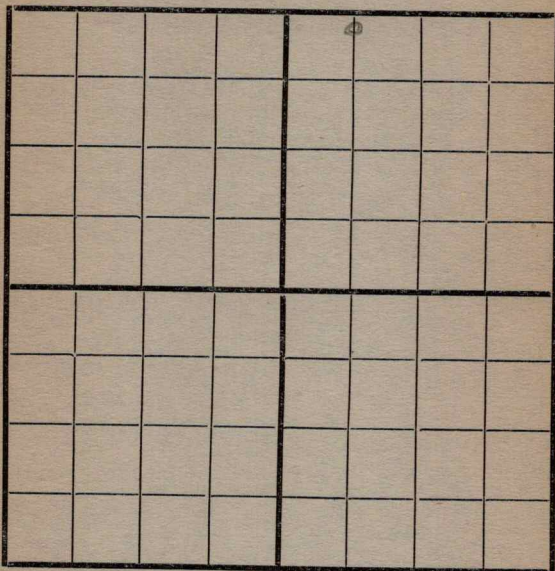

SOUTH

Location _____
 Rig Up _____
 Drilling and remarks _____

*Collapsed casing
 190's*

RECORD

Cased _____ in. _____ Ft.
 Sand _____
 Gas _____
 Oil _____
 Total Depth _____

PRODUCTION


1st 24 hrs. Nat. _____
 1st 24 hrs. after shot _____
 Gas _____ Cu. Ft.
 Dry Hole _____
 Abandoned _____

Date

3/22, 1917 Condy Scout

Map No. _____ Sec. 16 Twp. 27 R. 4
 Well No. 18 scully Farm _____
Primmer Company _____

NORTH

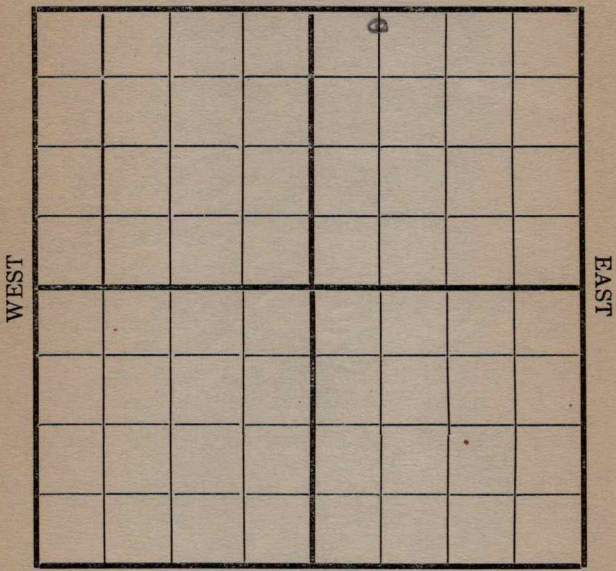

SOUTH

Location _____
 Rig Up _____
 Drilling and remarks _____

*Feeling for
 collapsed
 casing
 1900'*

RECORD

Cased _____ in. _____ Ft.
 Sand _____
 Gas _____
 Oil _____
 Total Depth _____

PRODUCTION

1st 24 hrs. Nat. _____
 1st 24 hrs. after shot _____
 Gas _____ Cu. Ft.
 Dry Hole _____
 Abandoned _____


Date 5/7, 1917 7. Carby Scout

Map No. _____ Sec. 16 Twp. 27 R. 4
 Well No. 18 Scully Farm _____
Prairie Company _____

NORTH

WEST

EAST

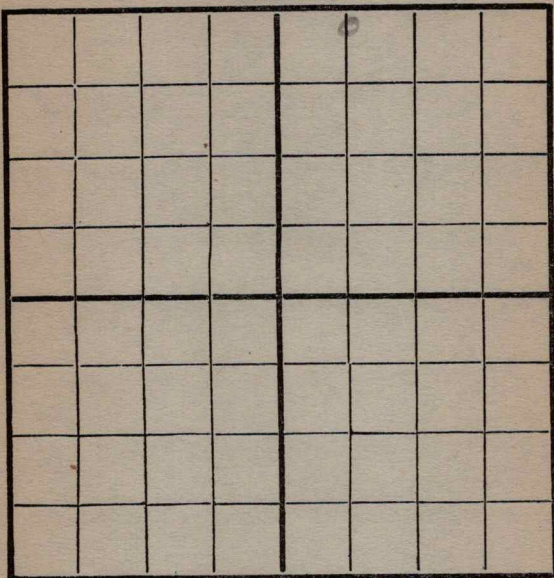

SOUTH

Location _____
 Rig Up _____
 Drilling and remarks _____

*Collapsed
 Casing
 1900'*

RECORD

Cased _____ in. _____ Ft.
 Sand _____
 Gas _____
 Oil _____
 Total Depth _____

PRODUCTION

1st 24 hrs. Nat. _____
 1st 24 hrs. after shot _____
 Gas _____ Cu. Ft.
 Dry Hole _____
 Abandoned _____

Date


5/25, 1917 Scully Scout

Map No. _____ Sec. 16 Twp. 27 R. 4
 Well No. 18 Scully Farm _____
Private Company _____

NORTH

WEST

EAST

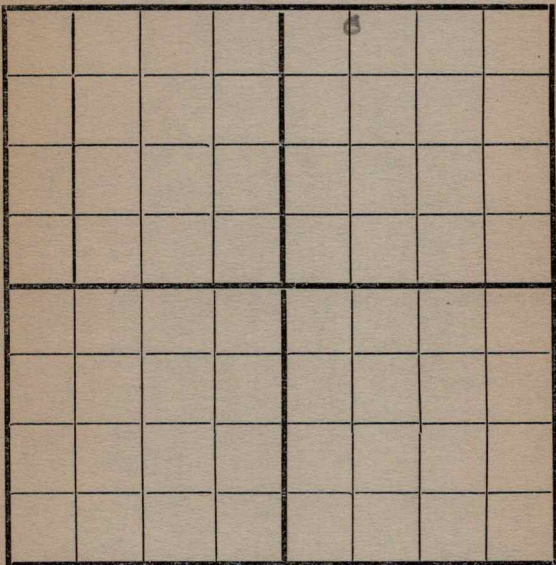

SOUTH

Location _____
 Rig Up _____
 Drilling and remarks _____

Collapsed
Casing
1908

RECORD

Cased _____ in. _____ Ft.
 Sand _____
 Gas _____
 Oil _____
 Total Depth _____

PRODUCTION

1st 24 hrs. Nat. _____
 1st 24 hrs. after shot _____
 Gas _____ Cu. Ft.
 Dry Hole _____
 Abandoned _____

Date

5/28, 1917 Cordell Scout

Map No. _____ Sec. 16 Twp. 27 R. 4Well No. 18 Seely Farm __________ Prairie Company _____

NORTH

WEST

EAST

SOUTH

Location _____

Rig Up _____

Drilling and remarks

*Fishing
Casing
1900*

RECORD

Cased _____ in. _____ Ft.

Sand _____

Gas _____

Oil _____

Total Depth _____

PRODUCTION

1st 24 hrs. Nat. _____

1st 24 hrs. after shot _____

Gas _____ Cu. Ft.

Dry Hole _____

Abandoned _____


Date

6/8, 191 *7*, _____ Scout

Map No. _____ Sec. 16 Twp. 27 R. 4
 Well No. 18 Sandy Farm _____
Prairie Company _____

NORTH

WEST

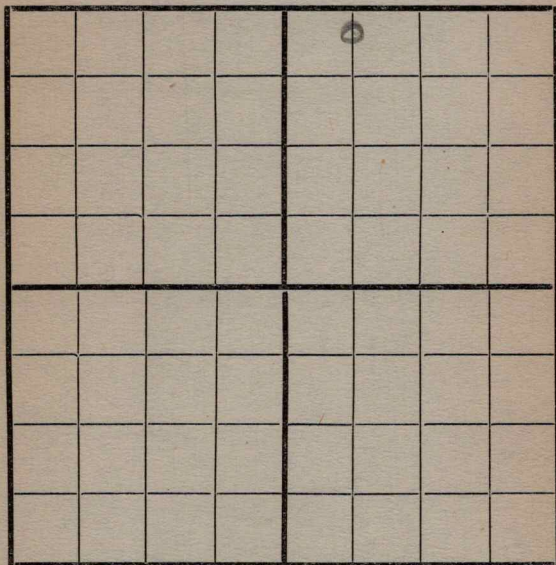

EAST

SOUTH

Location _____

Rig Up _____

Drilling and remarks

Collapsed
Logging

RECORD

Cased _____ in. _____ Ft.

Sand _____

Gas _____

Oil _____

Total Depth _____

PRODUCTION

1st 24 hrs. Nat. _____

1st 24 hrs. after shot _____

Gas _____ Cu. Ft.

Dry Hole _____


Abandoned _____

Date

6/12, 1917 Candy Scout

Map No. _____ Sec. 16 Twp. 27 R. 4
 Well No. 18 Scully Farm _____
Province Company _____

NORTH

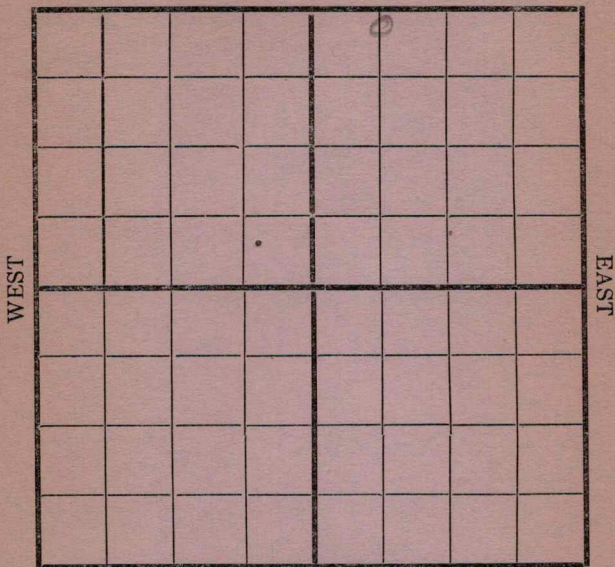

SOUTH

Location _____
 Rig Up _____
 Drilling and remarks _____

Shut Down
1900

RECORD

Cased _____ in. _____ Ft.
 Sand _____
 Gas _____
 Oil _____
 Total Depth _____

PRODUCTION


1st 24 hrs. Nat. _____
 1st 24 hrs. after shot _____
 Gas _____ Cu. Ft.
 Dry Hole _____
 Abandoned _____

Date

6/20, 1917 Candy Scout

Map No. _____ Sec. 16 Twp. 27 R. 4
 Well No. 18 Sully Farm _____
Provier Company _____

NORTH

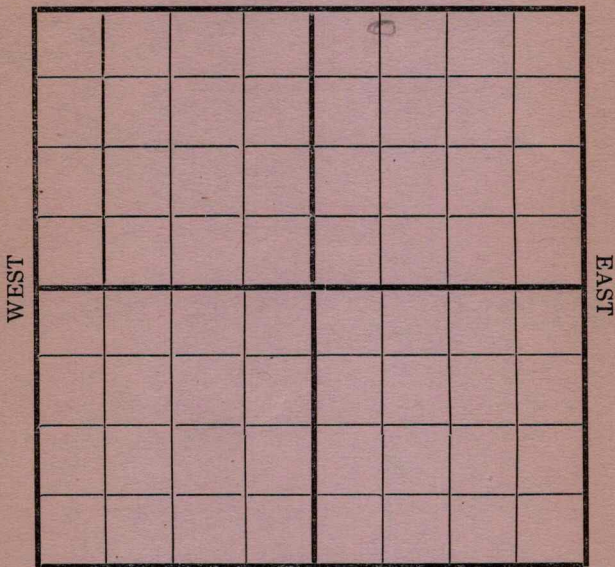

SOUTH

Location _____

Rig Up _____

Drilling and remarks

2124

RECORD

Cased _____ in. _____ Ft.

Sand _____

Gas _____

Oil _____

Total Depth _____

PRODUCTION

1st 24 hrs. Nat. _____

1st 24 hrs. after shot _____

Gas _____ Cu. Ft.

Dry Hole _____

Abandoned _____


Date

6/27, 1917 Condit Scout

Map No. _____ Sec. 16 Twp. 27 R. 4Well No. 18 Canley Farm _____
Francis Company

NORTH

WEST

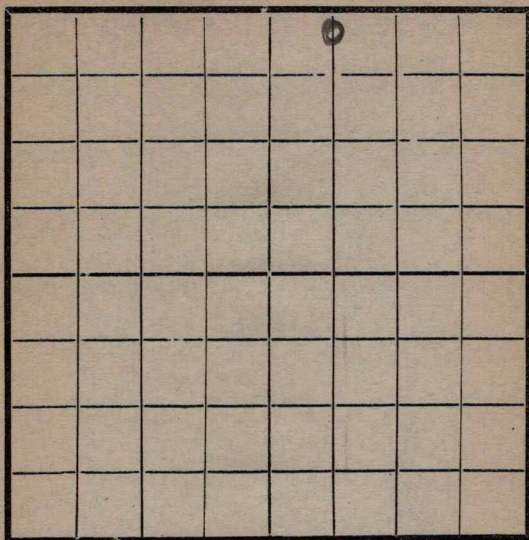

EAST

SOUTH

Location _____

Rig Up _____

Drilling and remarks

2150'

RECORD

Cased _____ in. _____ Ft.

Sand _____

Gas _____

Oil _____

Total Depth _____

PRODUCTION

1st 24 hrs. Nat. _____

1st 24 hrs. after shot _____

Gas _____ Cu. Ft.

Dry Hole _____

Abandoned _____

Date


7/6, 1917 Canley Scout

Map No. _____ Sec. 16 Twp. 27 R. 4

Well No. 18 _____ Farm _____
Prinice _____ Company

NORTH

WEST

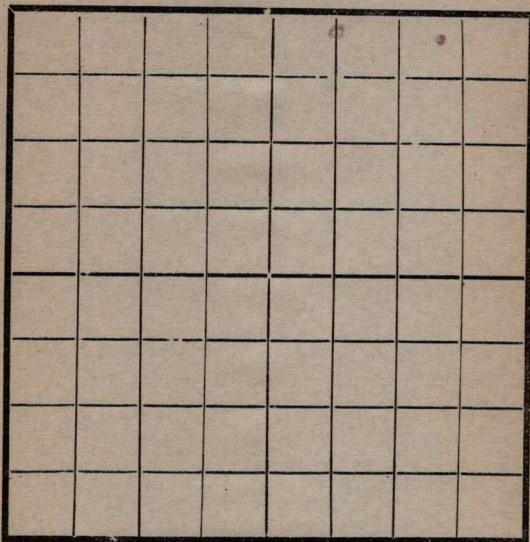

EAST

SOUTH

Location _____

Rig Up _____

Drilling and remarks

Shut Down

2150

RECORD

Cased _____ in. _____ Ft.

Sand _____

Gas _____

Oil _____

Total Depth _____

PRODUCTION

1st 24 hrs. Nat. _____

1st 24 hrs. after shot _____

Gas _____ Cu. Ft.

Dry Hole _____

Abandoned _____


Date

2/12, 1912 Cordy Scout

Map No. _____ Sec. 16 Twp. 27 R. 4Well No. 18 _____ Farm __________
_____ Company _____

NORTH

WEST

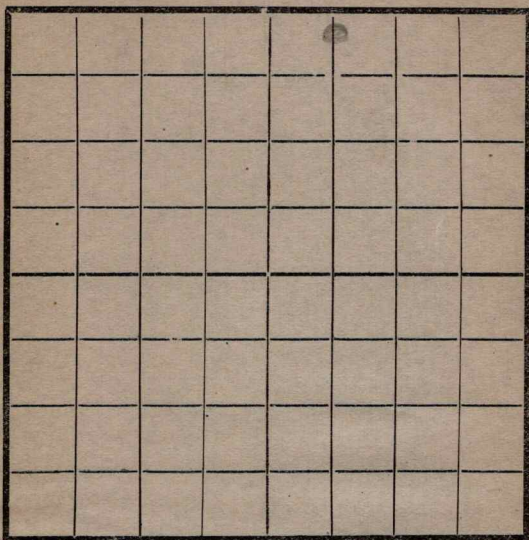

EAST

SOUTH

Location _____

Rig Up _____

Drilling and remarks

*Under
reaming
2150'*

RECORD

Cased _____ in. _____ Ft.

Sand _____

Gas _____

Oil _____

Total Depth _____

PRODUCTION

1st 24 hrs. Nat. _____

1st 24 hrs. after shot _____

Gas _____ Cu. Ft.

Dry Hole _____

Abandoned _____

Date

7/17 191*7* *Cordery* Scout

1001 K 11
Map No. 18 Sec. 16 Twp. 27 R. 4Well No. 18
Prairie Oil & Gas Company

Contractor

NORTH

WEST

EAST

COMPLETED

SOUTH

Location

Rig up

Drilling and Remarks:

Under Reamer
2150'

Dry & abandoned

RECORD

Cased in., ft.

Sand

Gas

Oil

Total Depth

PRODUCTION

1st 24 hrs. Nat.

1st 24 hrs. after shot

Gas Cu. Ft.

Dry Hole 2537

Abandoned

Date

7/17 1911 Cardiff Scout

Butler

KII
 MAP NO. **KANSAS** SEC. 16 TWP. 27S R. 1E
 WELL NO. 18 Scully
Pravie COMPANY

CONTRACTOR

SECTION PLAT

ABANDONED

_____ FT. FROM N. LINE
 _____ FT. FROM S. LINE
 _____ FT. FROM E. LINE
 _____ FT. FROM W. LINE

LOCATION _____

RIG UP _____

DRILLING AND REMARKS:

RECORD

CASED _____ IN. _____ FT.
 SAND _____
 GAS _____
 OIL _____
 TOTAL DEPTH 2537

PRODUCTION

1ST 24 HRS. NAT. _____
 1ST 24 HRS. AFTER SHOT _____
 GAS _____ CU. FT.
 DRY HOLE ☒
 ABANDONED ☒

[Red scribble]

DATE

Aug 6 1917 SCOUT