

Map No. Kansas Sec. 30 Twp. 24 R. 11


Well No. 1 Wiggins Farm

Ward Mc Ginnis Company

NORTH

WEST

EAST

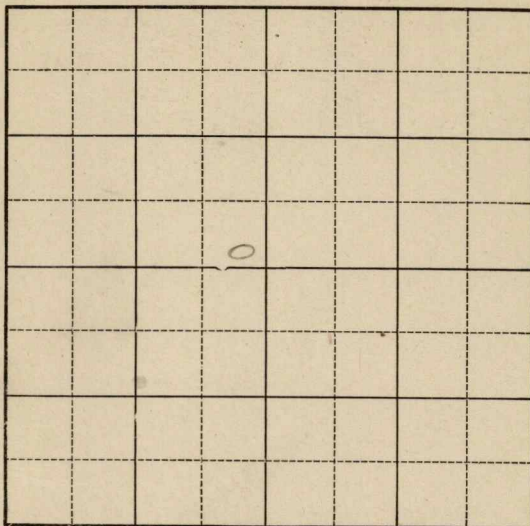

SOUTH

Location _____

Drilling Remarks

Rig Up _____

Drilling Remarks

RECORD

Cased _____ in. _____ ft.

Sand _____

Gas _____

Oil _____

Total Depth _____

PRODUCTION

1st 24 hrs. Nat. _____

1st 24 hrs. after shot _____

Gas _____ cu. ft.

Dry Hole _____

Abandoned _____

Greenwood Co
 Map No. Kansas Sec. 30 Twp. 24 R. 11
 Well No. 1 Wiggins Farm
Ward Mc Ginnis Company

NORTH

WEST

EAST

SOUTH

Ft. from N. Line

300 Ft. from S. Line300 Ft. from E. Line

Ft. from W. Line

REPORT

Date	
<u>1/25</u>	
<u>11/13</u>	Location
<u>11/19</u>	Runners
<u>11/27</u>	Digging up
<u>12/3</u>	Spudg
<u>12/10</u>	only 1000'
<u>12/17</u>	
<u>12/23</u>	T.S. (Brills) 1790'-1803' made several good flows, 41.9 gravity. 40' cavings in hole, cleaning out.
<u>12/31</u>	Top 2 and 1790-1808' T.D. shot 60 gts, estimated 250 bbls.
<u>1926</u>	
<u>1/8</u>	Sand 1790-1808 60 gts 600 Bbls 41.9 Gravity

Greenwood Co
 K16 KANSAS Map No. Sec. *30* Twp. *24* R. *11*

Well No. *1* *Wiggins*
Ward *Mc Grinnis* Company

Contractor

FIRST REPORTS

SECTION PLAT

Ft. from N. Line

Ft. from S. Line

Ft. from E. Line

Ft. from W. Line

Location

Rig up

Drilling and Remarks:

RECORD

Cased _____ in., _____ ft.

Sand _____

Gas _____

Oil _____

Total Depth _____

PRODUCTION

1st 24 hrs. Nat. _____

1st 24 hrs. after shot _____

Gas _____ Cu. Ft.

Dry Hole _____

Abandoned _____

Date

NOV 13 1925

CHAS. L. SHERWOOD

192

Scout

Greenwood Co
 Map No. *16* **KANSAS** Sec. *30* Twp. *24* R. *11*
 Well No. *1* *Wiggins*
Ward Mc Sinner Company

Contractor

COMPLETED

SECTION PLAT

Ft. from N. Line

300 Ft. from S. Line*300* Ft. from E. Line

Ft. from W. Line

Location

Rig up

Drilling and Remarks:

*bay Pumping**600 bhs.**41.9 Gravity*

RECORD

Cased _____ in., _____ ft.

Sand *1790* *1808*

Gas _____

Oil _____

Total Depth *1808*

PRODUCTION

1st 24 hrs. Nat. _____

1st 24 hrs. after shot _____

Gas _____ Cu. Ft.

Dry Hole _____

Abandoned _____

Date

JAN 8 1926 *192* **CHAS. L. SHERWOOD** Scout