

Wood

Form 51-5M-2-29-34703

Map No.

KANSAS

Sec.

19

Twp.

23

R.

14

Well No.

G-1-10 Dryer
Girdley Oil Co.

Farm


Company

NORTH

WEST

EAST

SOUTH

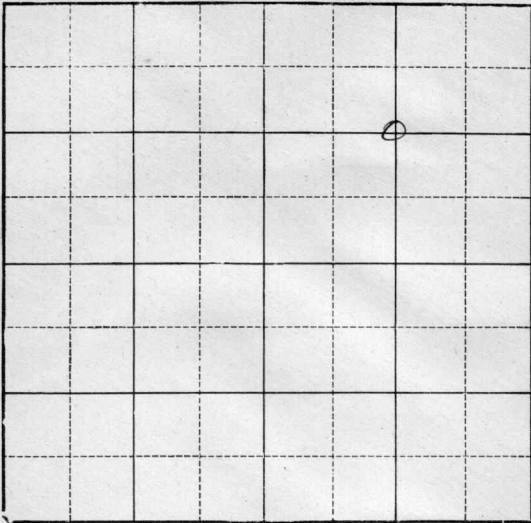

Location

Drilling Remarks

Rig Up

Drilling Remarks

RECORD

Cased in. ft.

Sand

Gas

Oil

Total Depth

PRODUCTION

1st 24 hrs. Nat.

1st 24 hrs. after shot

Gas cu. ft.

Dry Hole

Abandoned

Map No. _____ Sec. 19 Twp. 23 R. 14

Well No. 1 Dryer

Grissley _____ Company

_____ Contractor

FIRST REPORTS
ABANDONED

_____ Ft. from N. Line

_____ Ft. from S. Line

_____ Ft. from E. Line

_____ Ft. from W. Line

SECTION PLAT

Location _____

Rig up _____

Drilling and Remarks:

RECORD

Cased _____ in., _____ ft.

Sand _____

Gas _____

Oil _____

Total Depth 1700

PRODUCTION

1st 24 hrs. Nat. _____

1st 24 hrs. after shot _____

Gas _____ Cu. Ft.

Dry Hole ✓

Abandoned ✓

Date

_____ 192 _____

Sherwood

Scout