


Section 20 30 Township 23 Range 14 E

Well No. # 2 McClaskey

Company Thomas McLaskey

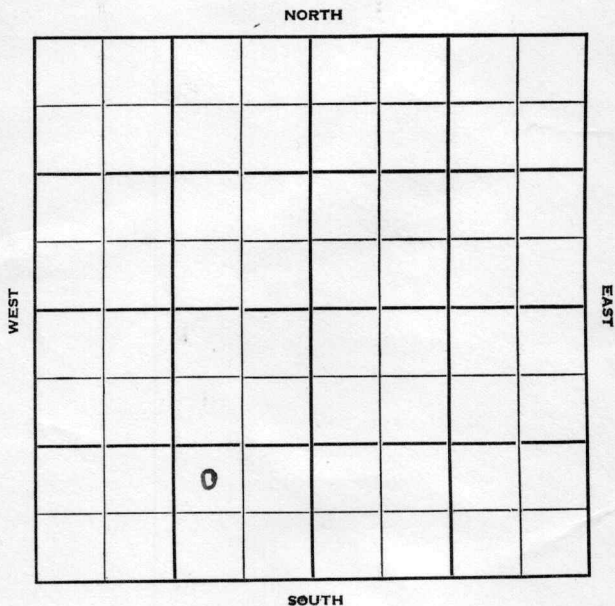

Woodson

KANSAS

Sec. ~~29~~²⁰ Twp. 23 R. 14 E

Well No. # 2 McClaskey Farm

Thomas McLaskey Company

Contractor

Ft. from N. Line


NORTH

990 Ft. from S. Line

990 Ft. from E. Line

Ft. from W. Line

NW SE SW

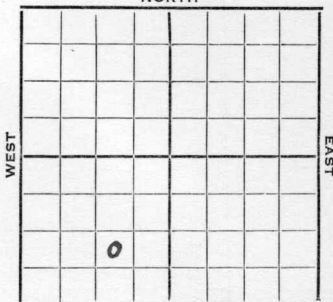

SOUTH

1952

REPORT

6/4

Miss 1623' Shut down @ 1632'

6/11

Oil Well TD 1632'

Miss. 1623 5" @ 1624'

10/ 1618-28 TD 1632'

Comp. 15 bopd

COMPLETED

County **Woodson** State **Kansas**

Sec. **29** (Blk. **23**) (Sur. **14E**) Map No.

Operator Thomas McLaskey

Well No. **2** Farm **McClaskey**

Elev.	Location	NW	SE	SW
-------	----------	----	----	----

290 Ft. From S Line SW

990 Ft. From **E** Line Quarter

1st. Report JUN 4 1952

Completion

Remarks

Spudding Date _____

Drlq. Data

Miss. 1623 Shut down @ 1632

J. G. McGEHEE

Kansas

Map No. _____ Sec. 20 Twp. 23 R. 14EWell No. 2 McClaskey_____
Thomas McClaskey _____ Company_____
Contractor

NW SE SW

SECTION PLAT

	o		

Ft. from N. Line990 _____
Ft. from S. Line990 _____
Ft. from E. Line_____
Ft. from W. LineWoodson County

Location _____

Rig up _____

Drilling and Remarks:

Reported

29-23-14E

RECORD

Cased _____ in., _____ ft.

Sand _____

Gas _____

Oil _____

Total Depth _____

PRODUCTION

1st 24 hrs. Nat. _____

1st 24 hrs. after shot _____


Gas _____ Cu. Ft.

Dry Hole _____

Abandoned _____

Date

JUN 11 195219J. G. McGEHEEScout

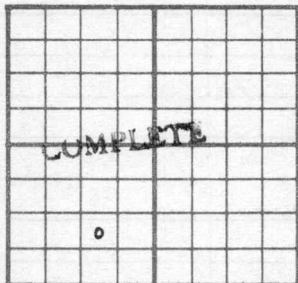County Woodson State KansasSec. 20 (Blk.
Twp.) 23 (Sur.
Rge.) 14E Map No.Operator Thomas McClaskeyWell No. 2 Farm McClaskeyElev. Location NW SE SW990 Ft. From S Line SW990 Ft. From E Line Quarter

1st. Report

Completion JUN 11 1952

Remarks

Spudding Date

Drig. Data Oil well TD 1632Miss. 1623 5" @ 1624 10/ 1618-28TD 1632 Comp. 15 bopd

J. G. McGEHEE