


Map No. _____ Sec. 16 Twp. 27 R. 9

Well No. 72 Dooly Farm _____

Company

NORTH

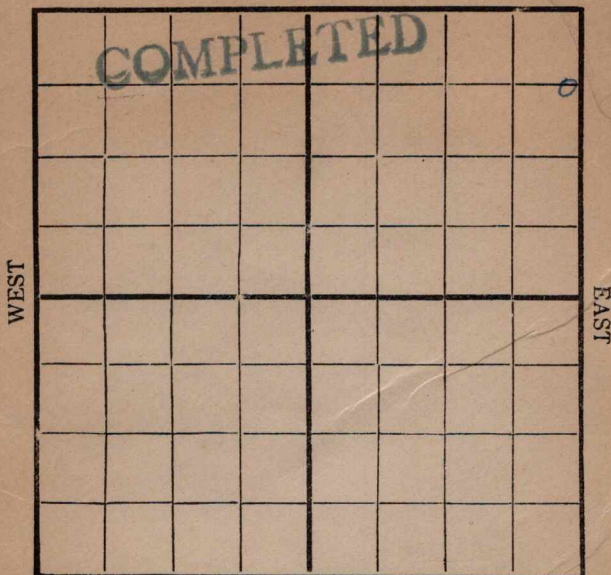

Location -----

Drilling Remarks:

Rig Up-----

Drilling Remarks:

RECORD

Cased_____ in_____Ft.

Sand -----

Gas _____

Oil _____

Total Depth_____

PRODUCTION

1st 24 hrs. Nat-----

1st 24 hrs. after shot-----

Gas_____Cu. Ft.

Dry Hole-----

Abandoned -----

Map No. _____ Sec. 16 Twp. 27 R. 4Well No. 23 Scully Farm __________Pringle Company _____

NORTH

WEST

EAST

SOUTH

Location _____

Rig Up ☒ _____

Drilling and remarks

@ loose location
to gas well

FIRST REPORT

RECORD

Cased _____ in. _____ Ft.

Sand _____

Gas _____

Oil _____

Total Depth _____

PRODUCTION

1st 24 hrs. Nat. _____

1st 24 hrs. after shot _____

Gas _____ Cu. Ft.

Dry Hole _____

Abandoned _____

Date

4/17, 1917 Camel Scout

Map No. _____ Sec. 16 Twp. 22 R. 4
 Well No. 23 Scully Farm _____
Prairie Company _____

NORTH

WEST

EAST

SOUTH

Location _____
 Rig Up _____
 Drilling and remarks _____

RECORD

Cased _____ in. _____ Ft.
 Sand _____
 Gas _____
 Oil _____
 Total Depth _____

PRODUCTION

1st 24 hrs. Nat. _____
 1st 24 hrs. after shot _____
 Gas _____ Cu. Ft.
 Dry Hole _____
 Abandoned _____

Date


4/24, 1917 Scully Scout

Map No. _____ Sec. 16 Twp. 27 R. 4
 Well No. 23 Sandy Farm _____
Prine Company _____

NORTH

WEST

EAST

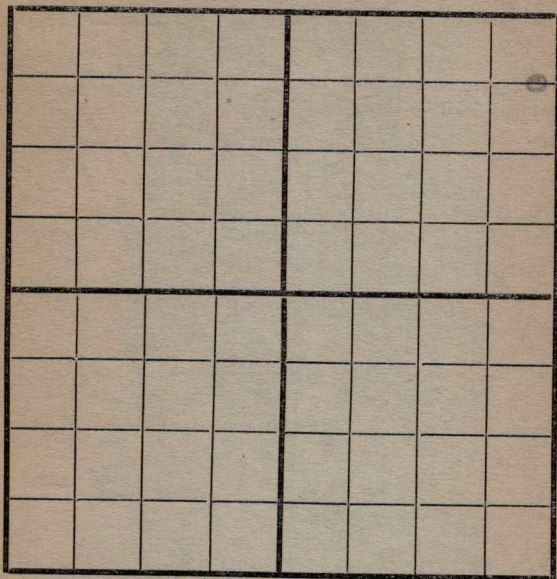

SOUTH

Location _____
 Rig Up _____
 Drilling and remarks _____

RECORD

Cased _____ in. _____ Ft.
 Sand _____
 Gas _____
 Oil _____
 Total Depth _____

PRODUCTION

1st 24 hrs. Nat. _____
 1st 24 hrs. after shot _____
 Gas _____ Cu. Ft.
 Dry Hole _____
 Abandoned _____

Date

5/2, 1917 C. D. J. Scout

WEST

EAST

SOUTH

Location _____
Rig Up _____
Drilling and remarks _____


Cased _____ in. _____ Ft.
 Sand _____
 Gas _____
 Oil _____
 Total Depth _____

1st 24 hrs. Nat.
1st 24 hrs. after shot
Gas Cu. Ft.
Dry Hole
Abandoned

Date 5/17, 1917 Carl Scout

Map No. _____ Sec. 16 Twp. 27 R. 4
 Well No. 23 Scully Farm _____
Prairie Company _____

NORTH

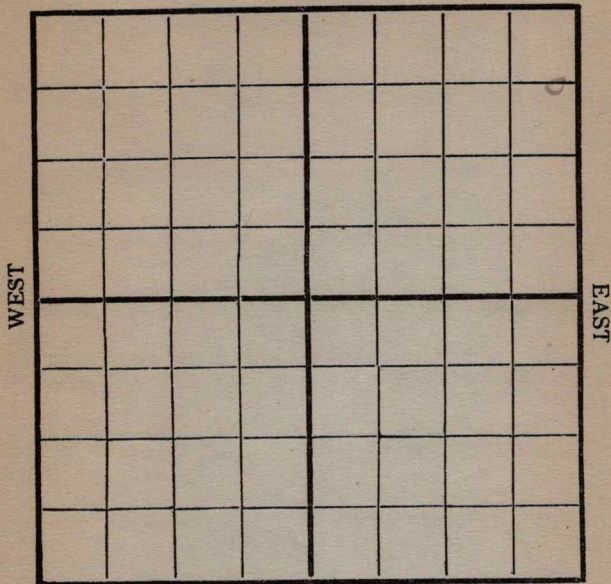

SOUTH

Location _____
 Rig Up _____
 Drilling and remarks _____

RECORD

Cased _____ in. _____ Ft.
 Sand _____
 Gas _____
 Oil _____
 Total Depth _____


PRODUCTION

1st 24 hrs. Nat. _____
 1st 24 hrs. after shot _____
 Gas _____ Cu. Ft.
 Dry Hole _____
 Abandoned _____

Date 5/25 1917 C. Scully Scout

Map No. _____ Sec. 16 Twp. 27 R. 4
 Well No. 23 Scout Farm
Pringle Company

NORTH

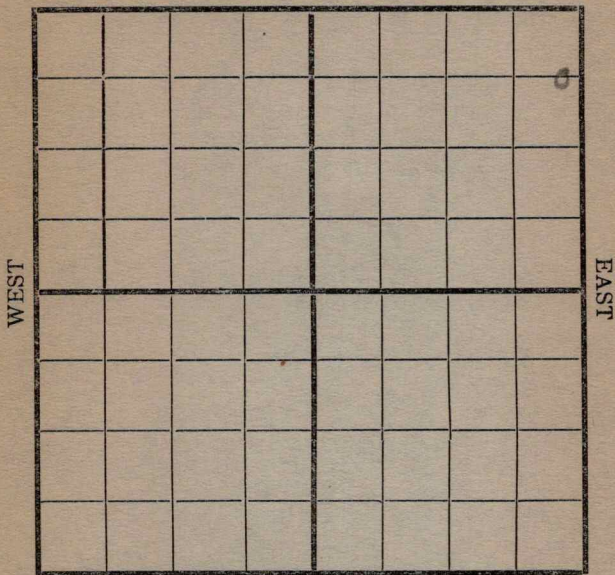

SOUTH

Location _____
 Rig Up _____
 Drilling and remarks

450

RECORD

Cased _____ in. _____ Ft.
 Sand _____
 Gas _____
 Oil _____
 Total Depth _____

PRODUCTION

1st 24 hrs. Nat. _____
 1st 24 hrs. after shot _____
 Gas _____ Cu. Ft.
 Dry Hole _____
 Abandoned _____

Date

5/28, 1917 Scout Scout

Map No. _____ Sec. 16 Twp. 27 R. 4Well No. 23, Sandy Farm __________Prairie Company _____

NORTH

WEST

EAST

SOUTH

Location _____

Rig Up _____

Drilling and remarks

Blind
Down
450

RECORD

Cased _____ in. _____ Ft.

Sand _____

Gas _____

Oil _____

Total Depth _____

PRODUCTION

1st 24 hrs. Nat. _____

1st 24 hrs. after shot _____

Gas _____ Cu. Ft.

Dry Hole _____

Abandoned _____

Date

6/20, 1917 C. Conroy Scout

WEST

EAST

SOUTH

Rig Up-----

RECORD

Cased-----in. -----Ft.

Sand

Gas_____

Oil _____

Total Depth.....

PRODUCTION

1st 24 hrs. Nat.

1st 24 hrs. after shot-----

Gas_____Cu. Ft.

Dry Hole-----

Abandoned_____

Date _____


191

Scout

Map No. _____ Sec. 16 Twp. 27 R. 4Well No. 23 Sweeney Farm _____Prairie Company _____

NORTH

WEST

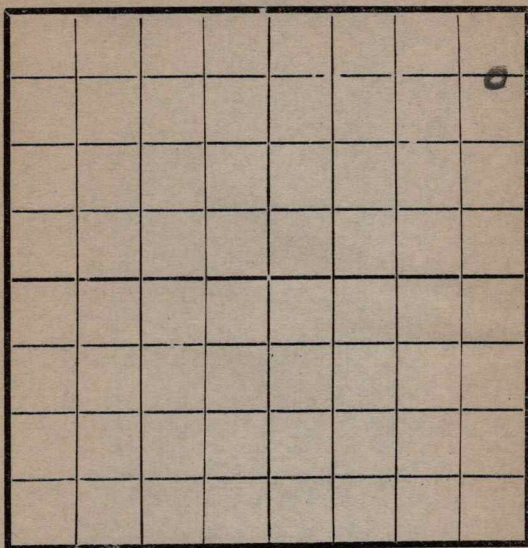

EAST

SOUTH

Location _____

Rig Up _____

Drilling and remarks _____

RECORD

Cased _____ in. _____ Ft.

Sand _____

Gas _____

Oil _____

Total Depth _____

PRODUCTION

1st 24 hrs. Nat. _____

1st 24 hrs. after shot _____

Gas _____ Cu. Ft.

Dry Hole _____

Abandoned _____

Date


7/6, 1917 Coney Scout

Map No. _____ Sec. 16 Twp. 27 R. 4

Well No. 23 Sandy Farm _____
Prairie Company

NORTH

WEST

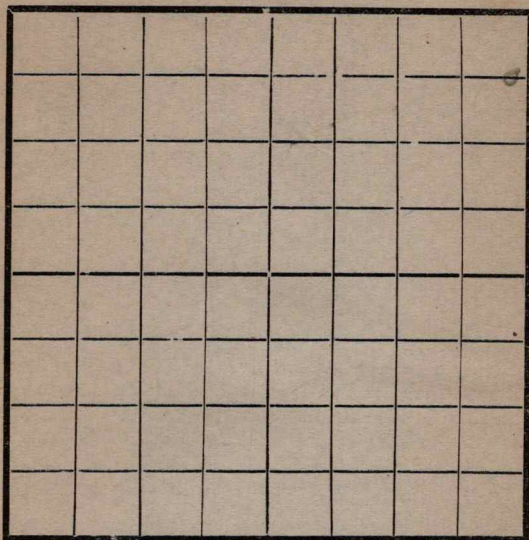

EAST

SOUTH

Location _____
 Rig Up _____
 Drilling and remarks _____

RECORD

Cased _____ in. _____ Ft.
 Sand _____
 Gas _____
 Oil _____
 Total Depth _____

PRODUCTION

1st 24 hrs. Nat. _____
 1st 24 hrs. after shot _____
 Gas _____ Cu. Ft.
 Dry Hole _____
 Abandoned _____

Date


7/12, 1917 Candis Scout

Map No. _____ Sec. 16 Twp. 27 R. 4

Well No. 23, Gully Farm _____
Prairie Company _____

NORTH

WEST

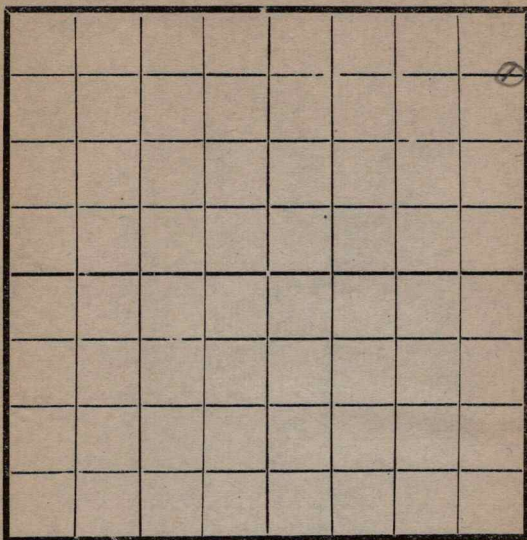

EAST

SOUTH

Location _____

Rig Up _____

Drilling and remarks

OK 1310,

RECORD

Cased _____ in. _____ Ft.

Sand _____

Gas _____

Oil _____

Total Depth _____

PRODUCTION

1st 24 hrs. Nat. _____

1st 24 hrs. after shot _____

Gas _____ Cu. Ft.

Dry Hole _____

Abandoned _____

Date

8-21, 1917 Lantz Scout

Map No. _____ Sec. 16 Twp. 27 E. 4
 Well No. 23 Sully Farm _____
Pioneer Company _____

NORTH

WEST

EAST

COMPLETED

SOUTH

Location _____

Rig Up _____

Drilling and remarks

Estimatedat 1751366

RECORD

Cased _____ in. _____ Ft.

Sand 2465-2513

Gas _____

Oil _____

Total Depth _____

PRODUCTION

1st 24 hrs. Nat. _____

1st 24 hrs. after shot _____

Gas _____ Cu. Ft.

Dry Hole _____

Abandoned _____

Date

9/19, 1917 Candy Scout