


Map No. Kaw Sec. 29 Twp. 24 R. 11
 Well No. 1 Wiggins Farm _____
J B Murphy Company _____
 NORTH

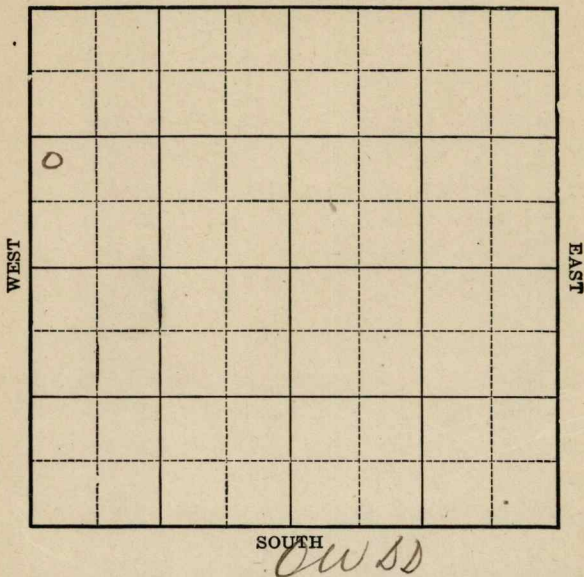

Location _____

Drilling Remarks _____

Rig Up _____

Drilling Remarks _____

RECORD

Cased _____ in. _____ ft.

Sand _____

Gas _____

Oil _____

Total Depth _____

PRODUCTION

1st 24 hrs. Nat. _____

1st. 24 hrs. after shot _____

Gas _____ cu. ft.

Dry Hole _____

Abandoned _____

Map No. Kan Sec. 29 Twp. 24 R. 11Well No. 1 Higgins Farm
J. B. Murphy Company


Ft. from N. Line

1020 Ft. from S. Line

Ft. from E. Line

300 Ft. from W. Line

NORTH

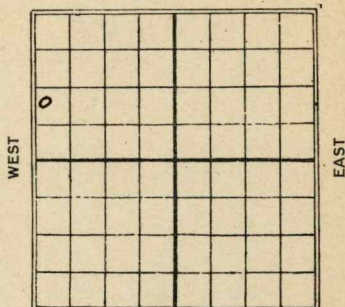

SOUTH

Date 1925 REPORT7/17 Location7/24 "Machine" digging up8/17 Rigin up.8/14 11508/20 13758/27 sand 1567-87 2d.40/151926 - 10WSS {5/17 Drilling deeper (2nd)2/24 W. R. - 16853/53/11 Abandoned 1785

K16 **KANSAS** *29* *24* *11*
 Map No. _____ Sec. _____ Twp. _____ R. _____

Well No. *1* *Higgins*

G. D. Murphy _____ Company

_____ Contractor

FIRST REPORTS

SECTION PLAT

_____ Ft. from N. Line

1020 _____ Ft. from S. Line

_____ Ft. from E. Line

300 _____ Ft. from W. Line

o			

old producing well going deeper.

Location _____

Rig up _____

Drilling and Remarks:

old hand record 1567

1587

Logging up to

well deeper.

RECORD

Cased _____ in., _____ ft.

Sand _____

Gas _____

Oil _____

Total Depth _____

PRODUCTION

1st 24 hrs. Nat. _____

1st 24 hrs. after shot _____

Gas _____ Cu. Ft.

Dry Hole _____

Abandoned _____

Date

FEB 17 1926

192

CHAS. L. SHERWOOD

Scout

K16 KANSAS *29* Sec. *24* Twp. *11* R. *11*

Well No. *1 Higgins*

J. B. Murphy Company

Contractor

COMPLETED

SECTION PLAT

_____ Ft. from N. Line

1020 Ft. from S. Line

_____ Ft. from E. Line

300 Ft. from W. Line

<i>0</i>			

ABANDONED

Location _____

Rig up _____

Drilling and Remarks:

Abandoned 20/1785

Crooked Hole

RECORD

Cased _____ in., _____ ft.

Sand _____

Gas _____

Oil _____

Total Depth *1785*

PRODUCTION

1st 24 hrs. Nat. _____

1st 24 hrs. after shot _____

Gas _____ Cu. Ft.

Dry Hole _____

Abandoned _____

Date

MAR 11 1926

CHAS. L. SHERWOOD

_____ 192_____ Scout

Sherwood Co

Map No. 16 KANSAS Sec. 29 Twp. 24 R. 11Well No. 1 Wiggins
J. B. Murphy Company

Contractor

COMPLETED

SECTION PLAT

Ft. from N. Line

1020 Ft. from S. Line

Ft. from E. Line

300 Ft. from W. Line

o			

Location -----

Rig up -----

Drilling and Remarks:

40/15 bhs.

RECORD

Cased 1567 in., 1587 ft.Sand 1567-1587

Gas -----

Oil -----

Total Depth 1587

PRODUCTION

1st 24 hrs. Nat. -----

1st 24 hrs. after shot -----

Gas ----- Cu. Ft.

Dry Hole -----

Abandoned -----

Date

AUG 27 1925

192

CHAS. L. SHERWOOD

Scout

Map No. 1656 Sec. 29 Twp. 24 R. 11Well No. WigginsJ. B. Murphy Company

Contractor

FIRST REPORTS**SECTION PLAT**

Ft. from N. Line

1000 Ft. from S. Line

Ft. from E. Line

300 Ft. from W. Line

0			

Location ☒

Rig up

Drilling and Remarks:

RECORD

Cased _____ in., _____ ft.

Sand _____

Gas _____

Oil _____

Total Depth _____

PRODUCTION

1st 24 hrs. Nat. _____

1st 24 hrs. after shot _____

Gas _____ Cu. Ft.

Dry Hole _____

Abandoned _____

Date

JUL 17 1925 CHAS. L. SHERWOOD

192

Scout